


FINAL PROOF SURVEY MAP
T30S, R6W, WM

SCALE 1" = 1320'

DOUGLAS COUNTY

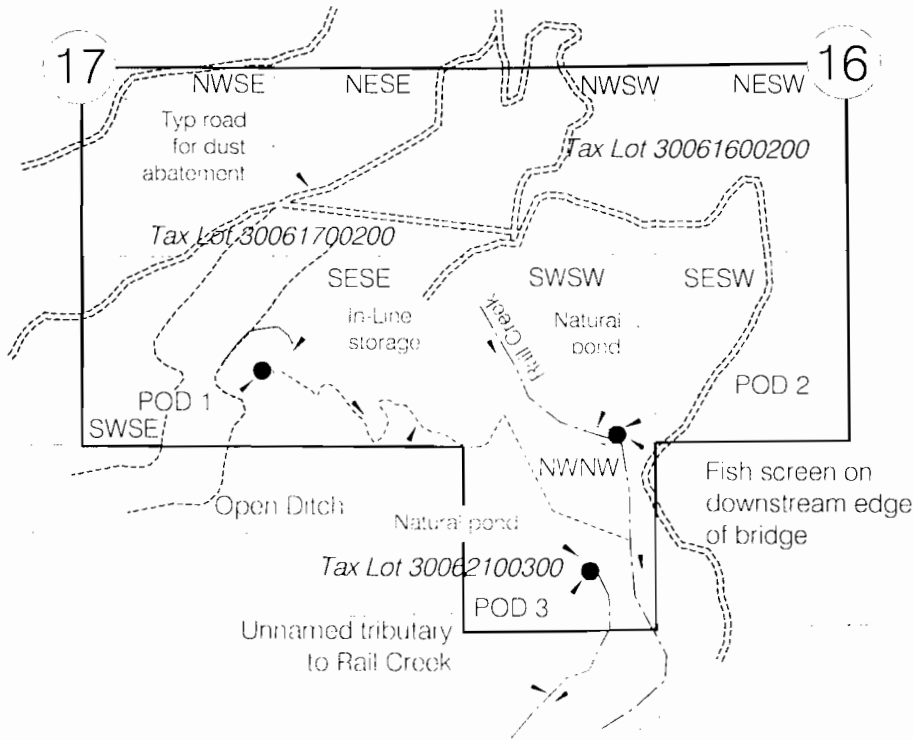

RECEIVED

JUN 10 2009

**WATER RESOURCES DEP
SALEM, OREGON**

21

POD 1 IS 520 FT N AND 1220 FT E FROM S1/4 COR OF SEC 17
POD 2 IS 90 FT N AND 1060 FT E FROM SW COR OF SEC 16
POD 3 IS 850 FT S AND 880 FT E FROM NW COR OF SEC 21

FINAL PROOF SURVEY
UNDER

Application No. T-9286

IN NAME OF

Nickel Mountain, LLC % Rick Barnes

Surveyed October 24, 2008 by M E Farr

MAP PREPARED FOR:
NICKEL MOUNTAIN, LLC
% RICK BARNES
3000 STEWART PARKWAY
ROSEBURG, OR 97470

MAP PREPARED BY:
MAURICE E FARR, CWRE
395 NE KIRBY AVENUE
ROSEBURG, OR 97470

THIS IS A LOCATION MAP FOR A FINAL PROOF SURVEY BY NICKEL MOUNTAIN, LLC. % RICK BARNES. THIS MAP IS FOR THE PURPOSE OF IDENTIFYING THE LOCATION OF THE WATER RIGHT ONLY AND IS NOT INTENDED TO PROVIDE LEGAL DIMENSIONS OR LOCATIONS OF PROPERTY OWNERSHIP LINES



EXPIRES 12 31 09