




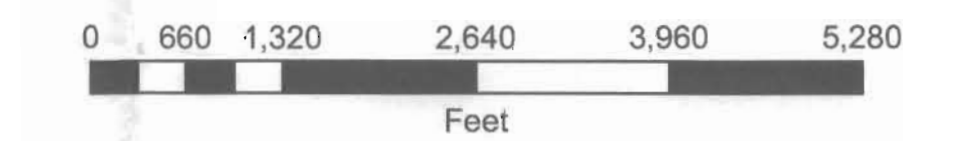
Santiam Water Control District

Final Proof Survey

Application	Permit
S-57185	S-43080
S-69054	S-51317
S-69055	S-51318

Legend


- Permit
- S-43080 - Primary Irrigation 
- S-51317 - Supplemental Irrigation 
- S-51318 - Primary Irrigation 
- District Boundary 



1 inch = 1,320 feet

Point of Diversion Located: 44° 47.801' N -122° 46.412' W

This map is not intended to provide legal dimensions or locations of property ownership lines. Drafted by Kelly Starnes - 4/17/2013

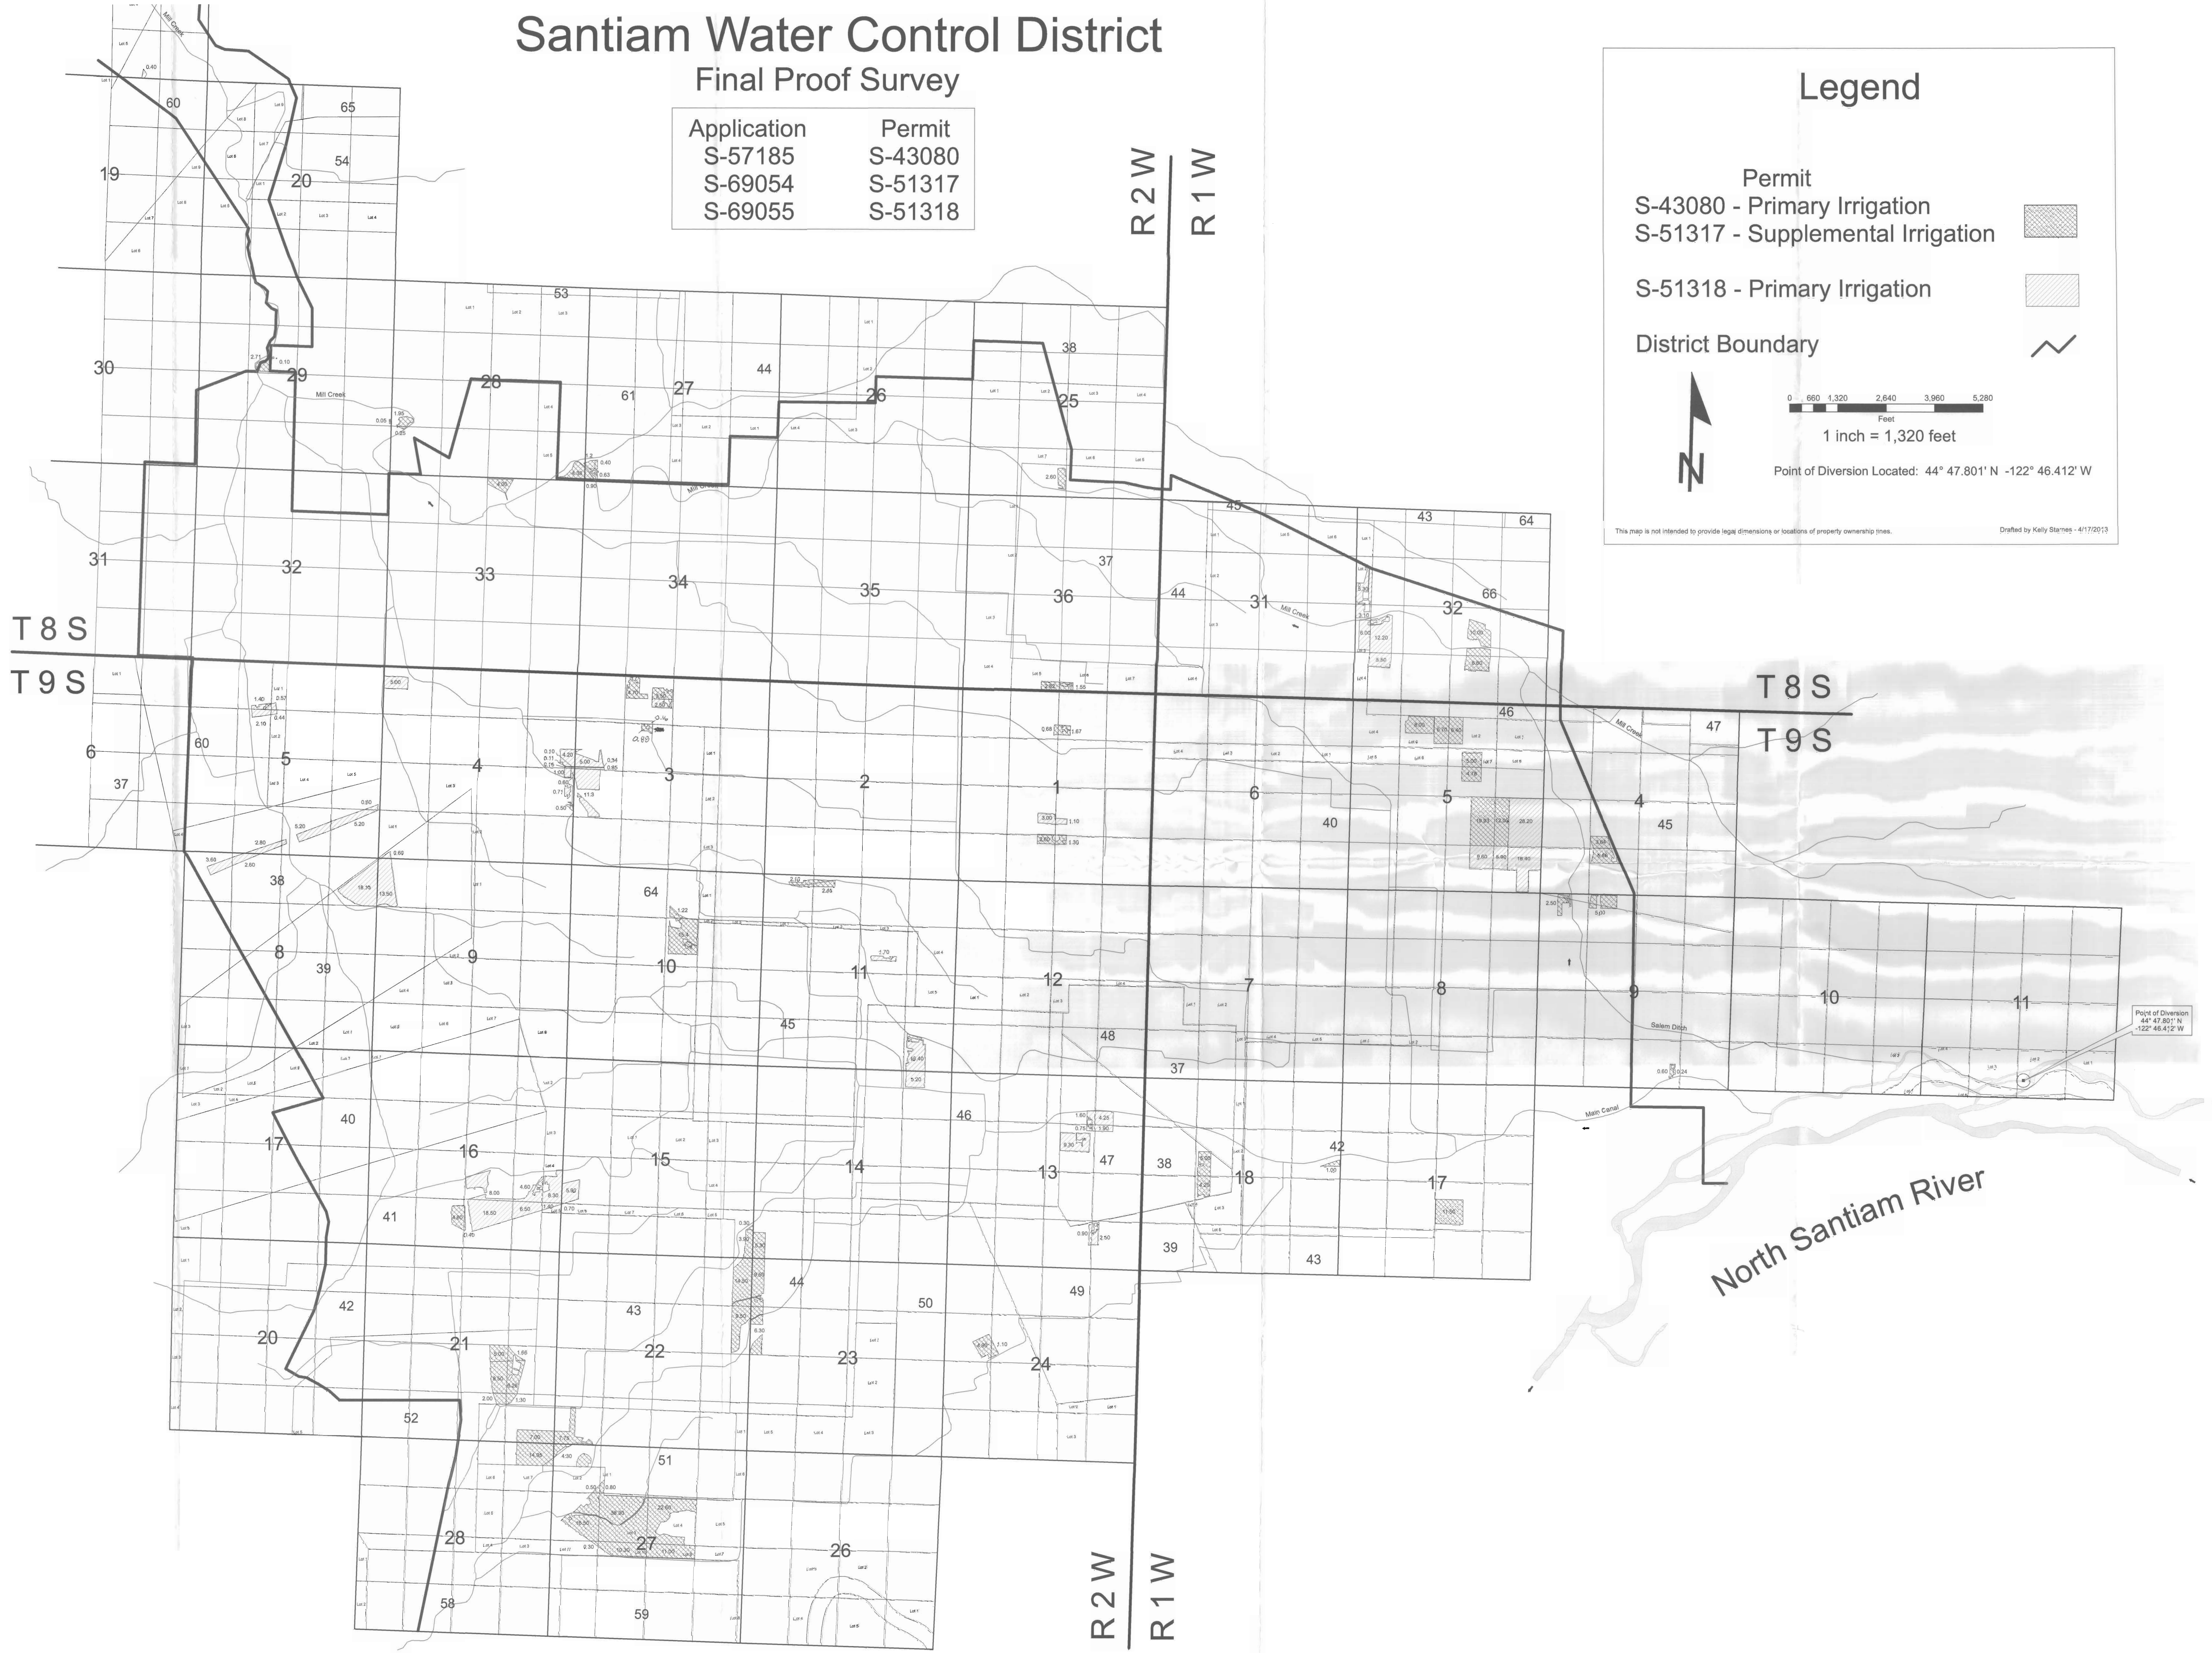

North Santiam River