

AMENDED APPLICATION MAP FOR
WATER RIGHT TRANSFER T9586

CHANGE IN PLACE OF USE &
POINT OF DIVERSION


IN THE NAME OF ROBERT & DEBORAH KELLER

SOUTH 1/2 OF SECTION 16, T. 29 S., R. 3 W., W.M.

SCALE:

1" = 400'

THE PURPOSE OF THIS MAP IS TO IDENTIFY
THE LOCATION OF THE WATER RIGHT. IT IS
NOT INTENDED TO PROVIDE INFORMATION
RELATIVE TO THE LOCATION OF PROPERTY
OWNERSHIP BOUNDARY LINES.

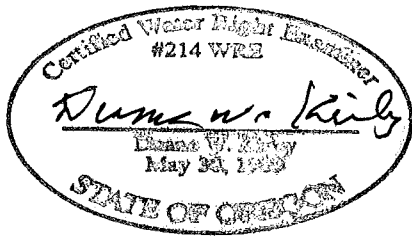

ORG. P.O.D.
N 11° 41' E 3016 FEET
FROM SOUTH 1/4 CORNER
SECTION 16.

N.W. of the S.E.
0.04 AC

WEAVER
CREEK

N.E. of the S.W.

S.E. of the S.W.
7.49 AC

SOUTH
MYRTLE
COUNTY
ROAD

4.30 AC

7.73 AC

0.04 AC

1.00 AC

3.74 AC

LAWN & GARDEN
AREA


7.53 AC

ADDITIONAL
POINT OF DIVERSION
1191' N, 579' E OF THE
SOUTH QUARTER CORNER
TO SECTION 16.

S.W. of the S.E.

8.73 AC

SOUTH
1/4 COR.
FD. B.C.

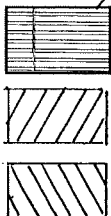

CERTIFICATE 8100 TRANSFER FROM - 7.53 AC.

CERTIFICATE 8100 TRANSFER TO - 7.53 AC.

CERTIFICATE 8100 REMAINING RIGHT - 12.47 AC.

RECEIVED

JUN 07 2011

WATER RESOURCES DEPT
SALEM, OREGON