




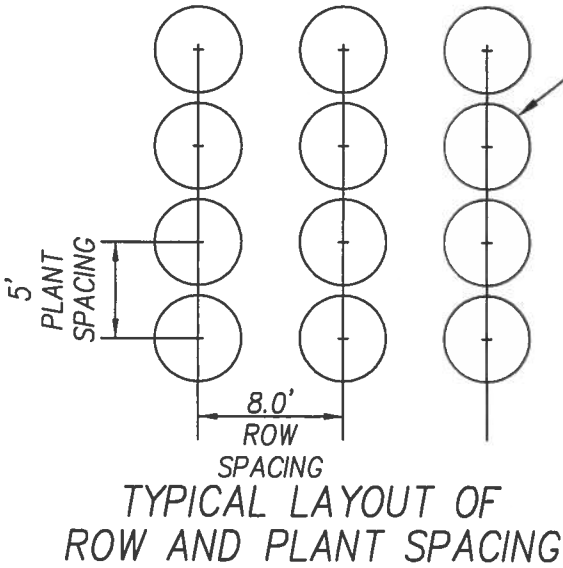

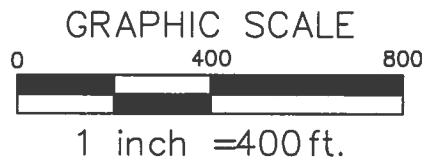

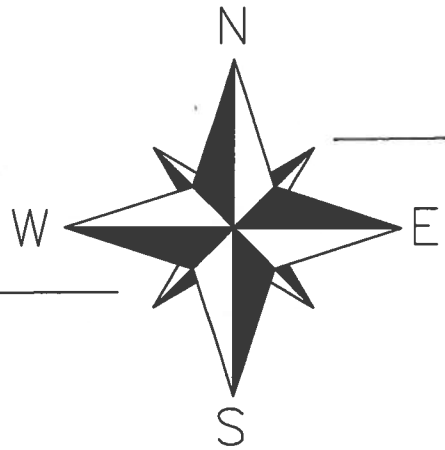


# CLAIM OF BENEFICIAL USE MAP

SECTIONS 3 AND 4, T1N, R4W, WM  
 LOTS 100 AND 202 OF TAX MAP 1N 4 SEC. 4 AND  
 LOTS 900 AND 901 OF TAX MAP 1N 4 SEC. 3  
 WASHINGTON COUNTY, OREGON  
 TUALATIN RIVER BASIN  
 TRANSFER T-9786


**PREPARED FOR:**  
 WILLAMETTE VALLEY VINEYARDS INC.  
 10850 NW SEAVEY ROAD  
 FOREST GROVE OREGON 97116



-  TRANSFERRED TO SEE ABOVE FIGURE FOR DETAILS
-  POINT OF DIVERSION (POD)
-  METER
-  EXISTING PIPELINES
-  PROPERTY BOUNDARY LINE
-  TAX LOT LINE
-  1/16TH SECTION

MAP BASES: WASHINGTON COUNTY TAX MAPS T1N R4W SEC. 3 AND SEC. 4  
 2008 AERIAL PHOTO FROM GOOGLE EARTH

THIS MAP WAS PREPARED FOR THE PURPOSE OF IDENTIFYING THE LOCATION OF A WATER RIGHT ONLY AND IS NOT INTENDED TO PROVIDE LEGAL DIMENSIONS OR LOCATION OF PROPERTY OWNERSHIP LINES.

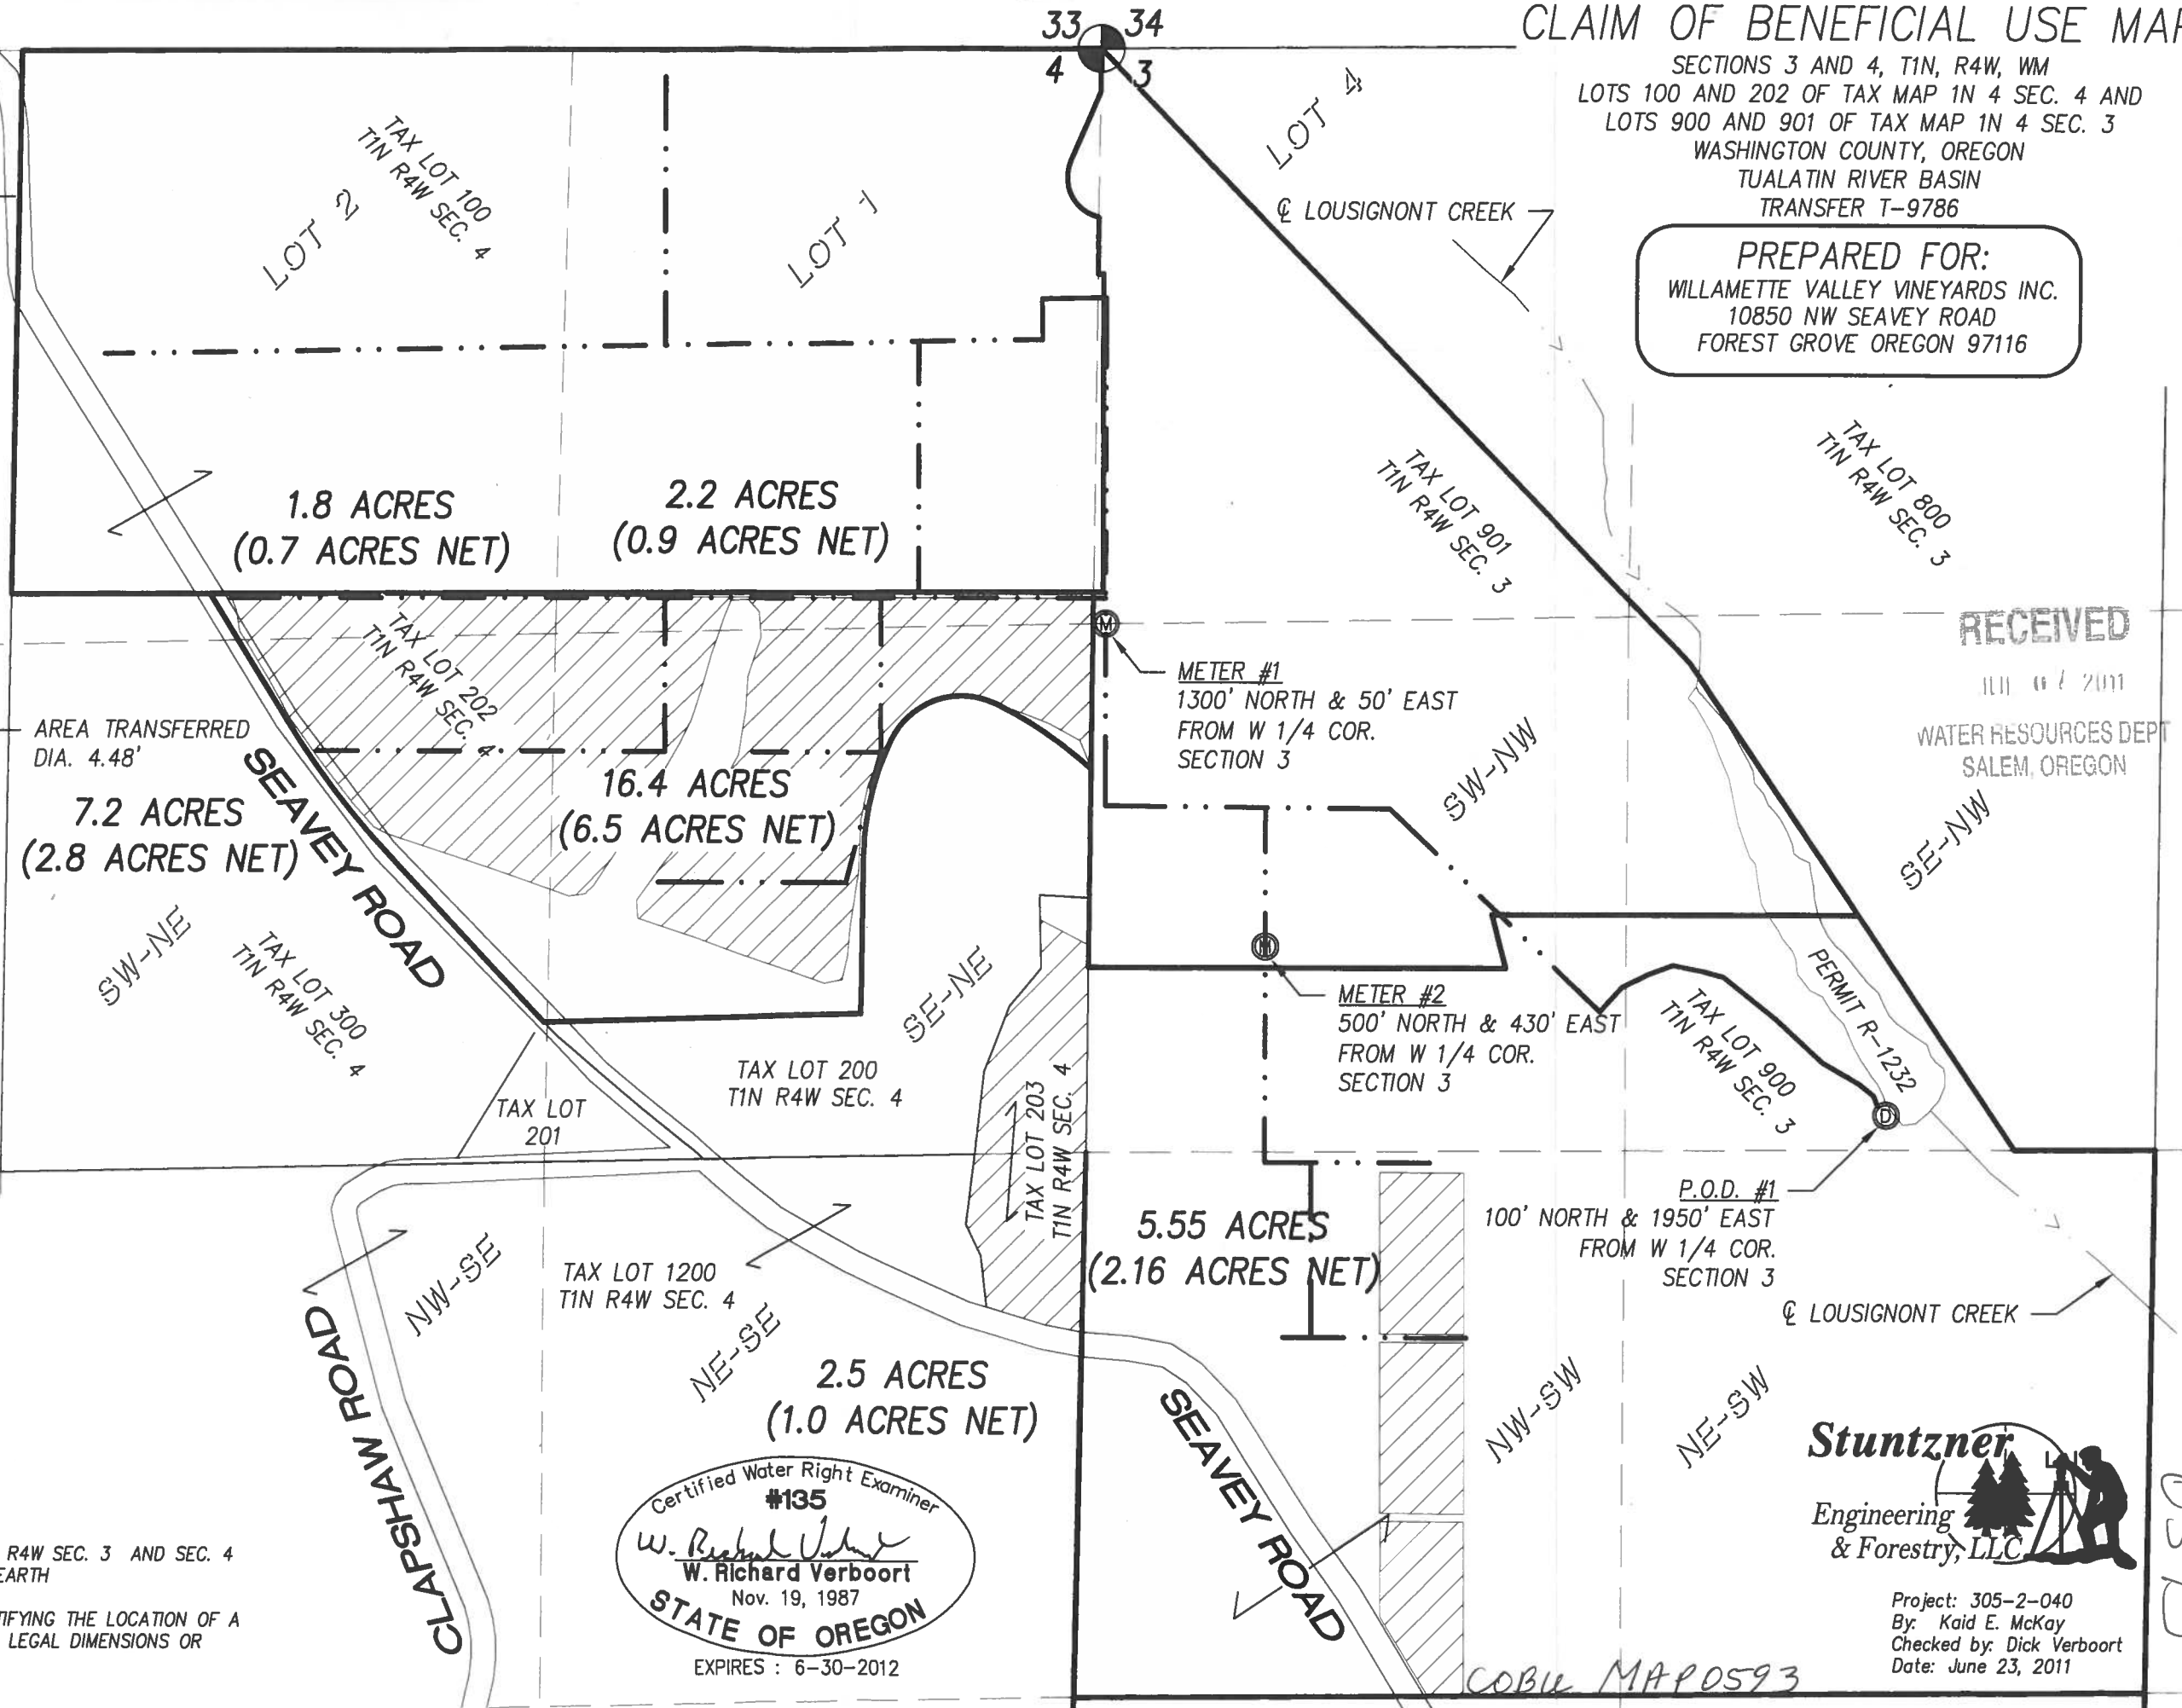

RECEIVED

JUN 23 2011

WATER RESOURCES DEPT  
 SALEM, OREGON

Certified Water Right Examiner  
 #135  
*W. Richard Verboort*  
 W. Richard Verboort  
 Nov. 19, 1987  
 STATE OF OREGON  
 EXPIRES : 6-30-2012

**Stuntzner**  
 Engineering & Forestry, LLC

Project: 305-2-040  
 By: Kaid E. McKay  
 Checked by: Dick Verboort  
 Date: June 23, 2011

COBU MAP 0593

0593