


SECTION 34, TWP.1 N. RANGE 10 E. W.M.
HOOD RIVER COUNTY, OREGON

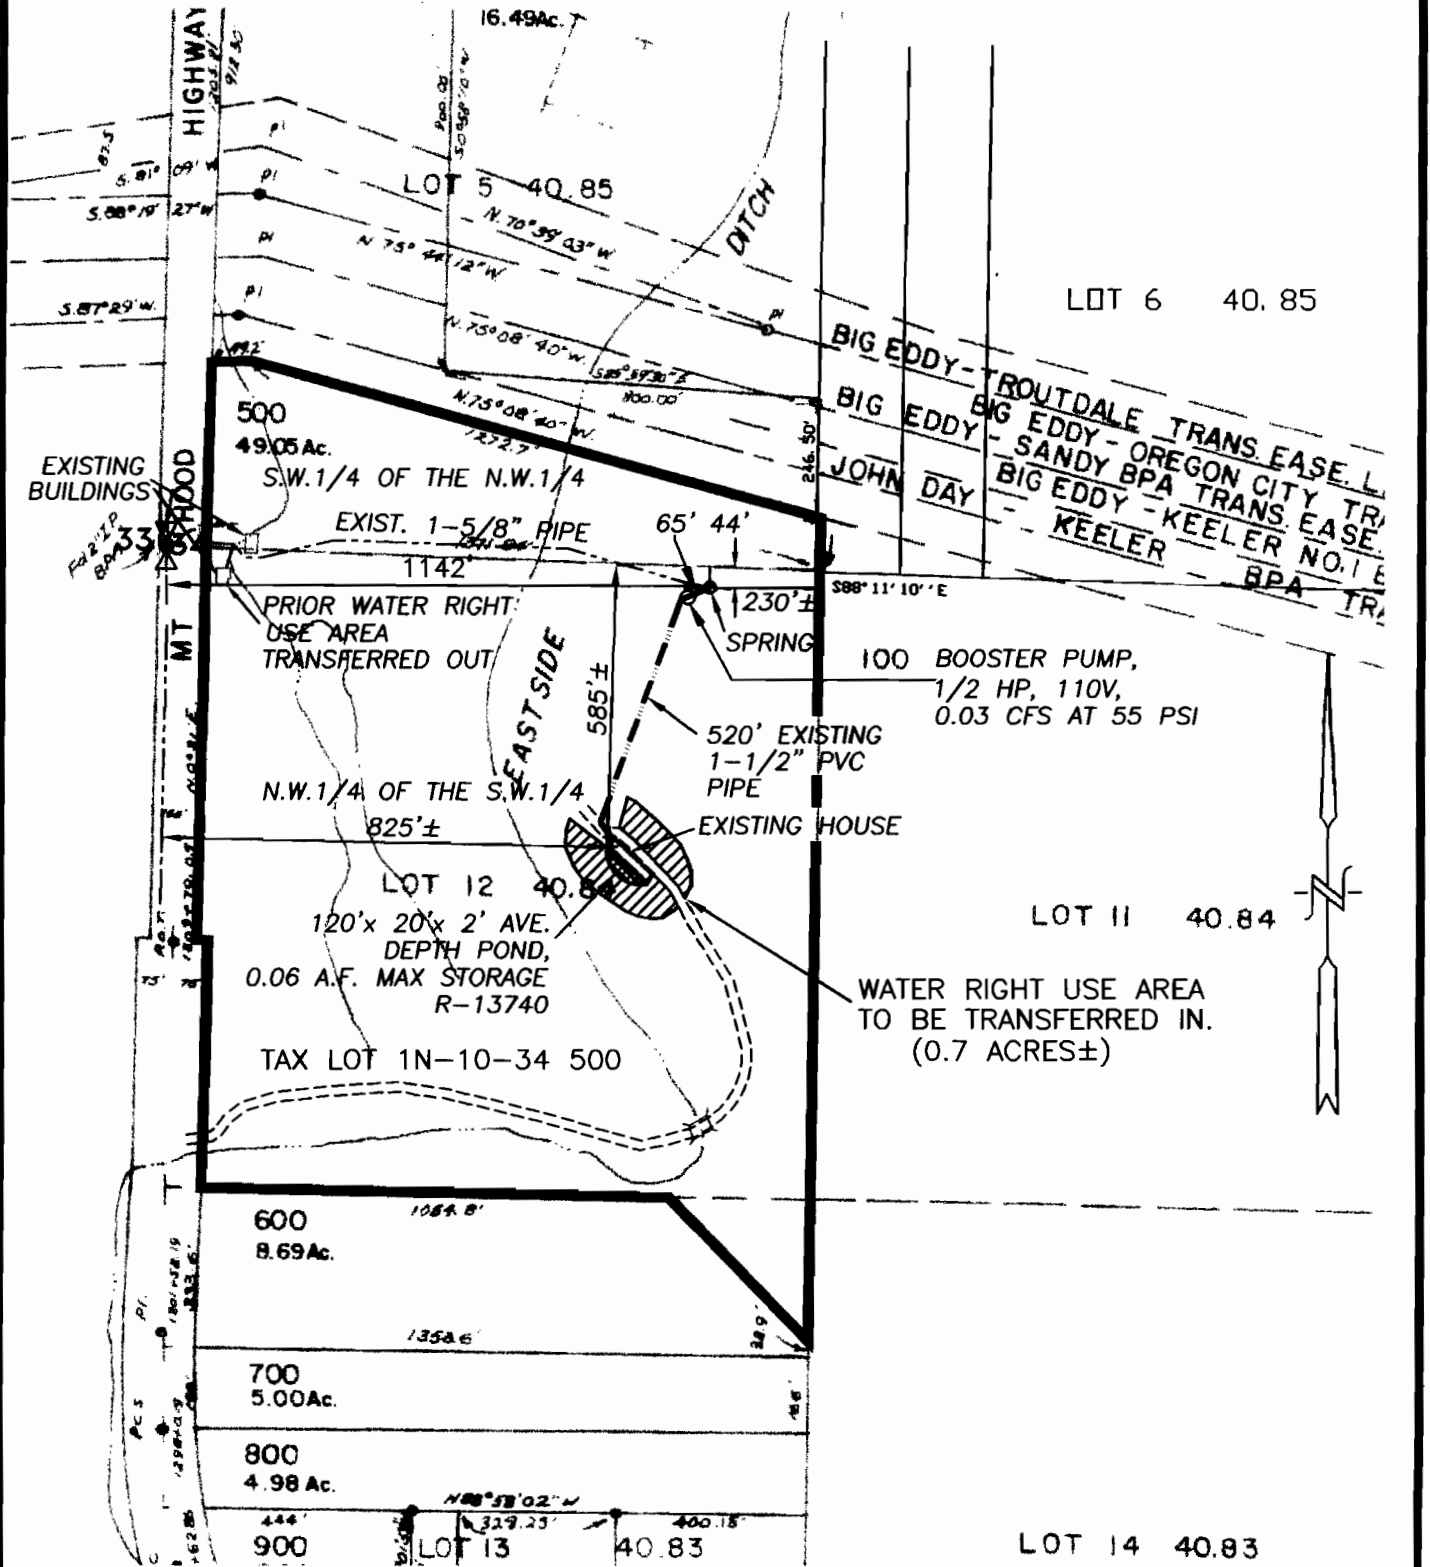

CLAIM OF BENEFICIAL USE

SCALE: 1" = 400'


APPLICATION No. T-9449 & R-85621

PERMIT No. T-9449 & R-13740

IN THE NAME OF:
GARY L. ROBINSON & KAREN D. JOHNSON, H.&W.

DATE: OCTOBER 11, 2005
REVISION #1: REVISE POND TIES (6/02/2003)

BY: **TENNESON ENGINEERING CORP.**
409 LINCOLN STREET,
THE DALLES, OREGON. 97058
PH. (541) 296-9177
FAX (541) 296-6657

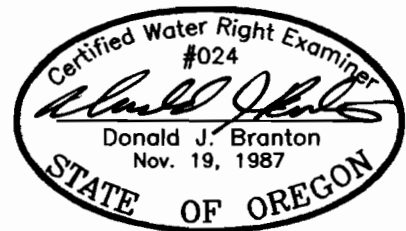

RENEW: 12/31/05

NOTE:

"THIS MAP IDENTIFIES THE LOCATION OF THE WATER RIGHT ONLY AND IS NOT INTENDED TO PROVIDE DIMENSIONS OR LOCATE PROPERTY OWNERSHIP LINES."

OCT 13 2005

W.O. #10741

WATER RESOURCES DEPT
SALEM, OREGON