


TOWNSHIP 2 SOUTH, RANGE 10 EAST, W.M.

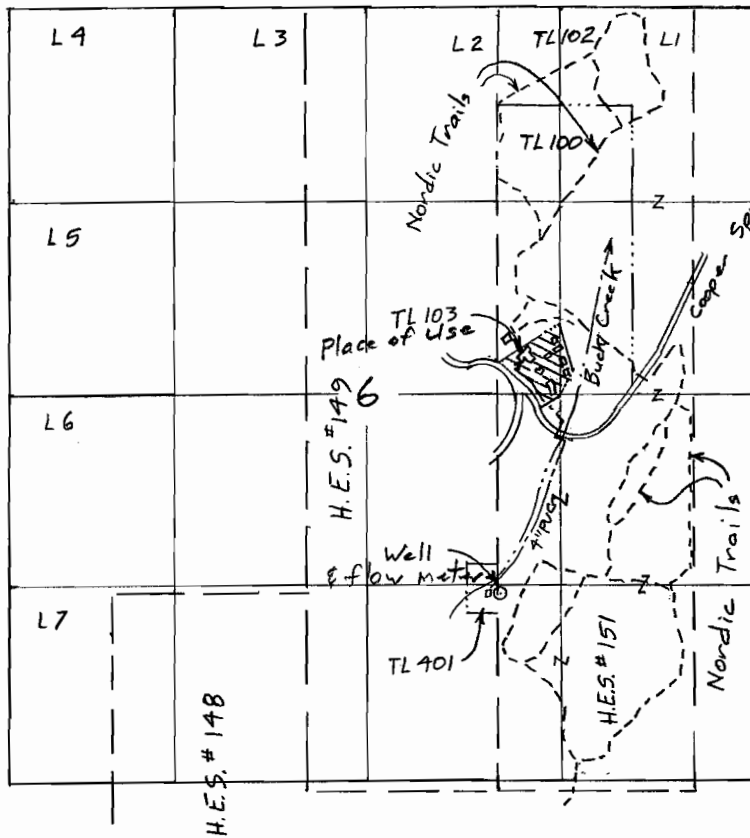

Scale 1" = 1320'
(4" = 1 mile)

Well located; 1370' S & 1740' W
from E 1/4 corner, section 6

Surveyed Feb 25, 2003
& Aug 17, 2004

App G-14655
Per G-13484

Claim of Beneficial Use Map
for
MEADOWS UTILITIES, LLC

RECEIVED

OCT 08 2011

WATER RESOURCE
SALEM, OREGON

This map is for the purpose of
locating a water right only
and has no intent to provide
legal dimensions or the location
of property lines.



Renewal Dec 31, 2013

ESTES SURVEYS, LLC

PO Box 17518 60382 Arnold Rd
Salem, OR 97305-7518 Bend, OR 97702
(503) 535-7699 (541) 382-7391

Amended Aug 2, 2012