

FINAL PROOF SURVEY OF A PERMIT TO CONSTRUCT A RESERVOIR

FOR: DALE & CARLEEN HOLLAND

BY: NATHAN R. REED, CWRE

SECTIONS 16&21, T24S, R4W, W.M. DOUGLAS COUNTY


APPLICATION NO. R-71067

PERMIT NO. R-11351

DATE SURVEYED: JUNE 29, 2013



SCALE: 1" = 400'

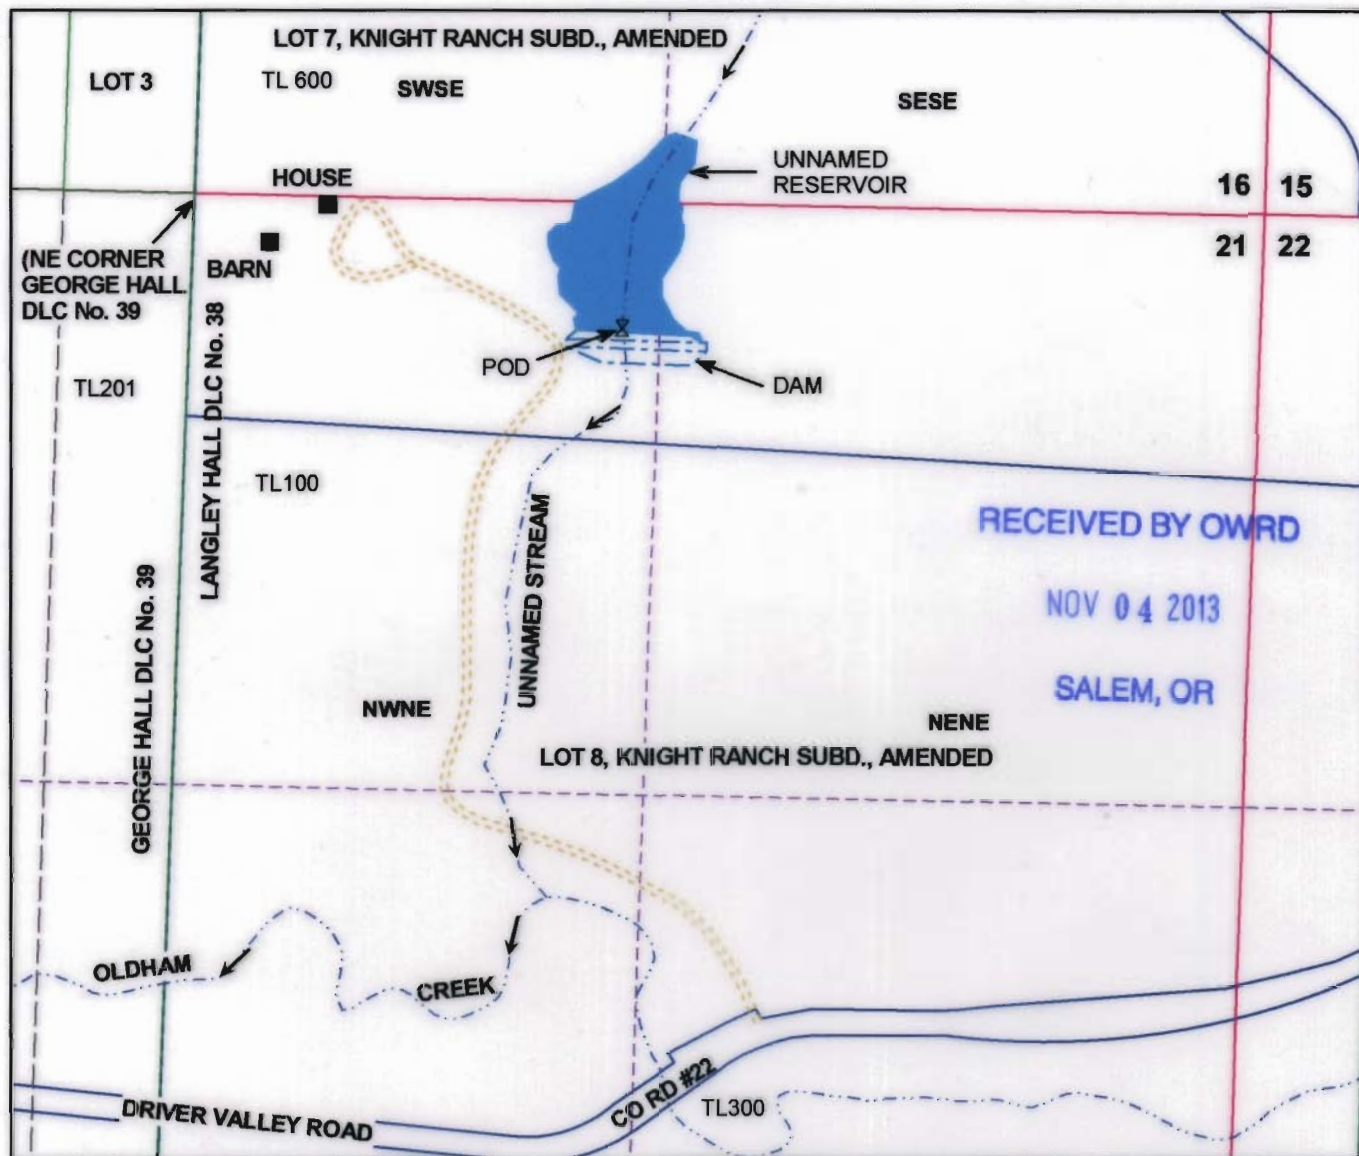

POD IS 250 FEET SOUTH AND 1500 FEET WEST FROM NE CORNER SEC 21

MAP PREPARED FOR:
DALE & CARLEEN HOLLAND
P.O. BOX 89
7250 DRIVER VALLEY ROAD
OAKLAND, OR 97462

Legend					
X	POD				
---	Stream	---	Dam	---	Gov_Lot
→	Flow_arrow	---	Roads	---	DLC
■	Reservoir	---	Structure	---	Section
		---		---	Parcels
		---		---	Sixteenth

THE PURPOSE OF THIS MAP IS TO IDENTIFY THE LOCATION OF THE WATER RIGHT. IT IS NOT INTENDED TO PROVIDE INFORMATION RELATIVE TO THE LOCATION OF PROPERTY OWNERSHIP BOUNDARY LINES.

MAP PREPARED BY:
NATHAN R. REED, P.E., CWRE
1113 SE CASS AV
ROSEBURG, OR 97470