

CLAIM OF BENEFICIAL USE

FOR: DALE & CARLEEN HOLLAND

BY: NATHAN R. REED, CWRE

SECTIONS 21, T24S, R4W, W.M. DOUGLAS COUNTY


APPLICATION NO. S-71068

PERMIT NO. S-54804

DATE SURVEYED: JUNE 29, 2013



SCALE: 1" = 400'

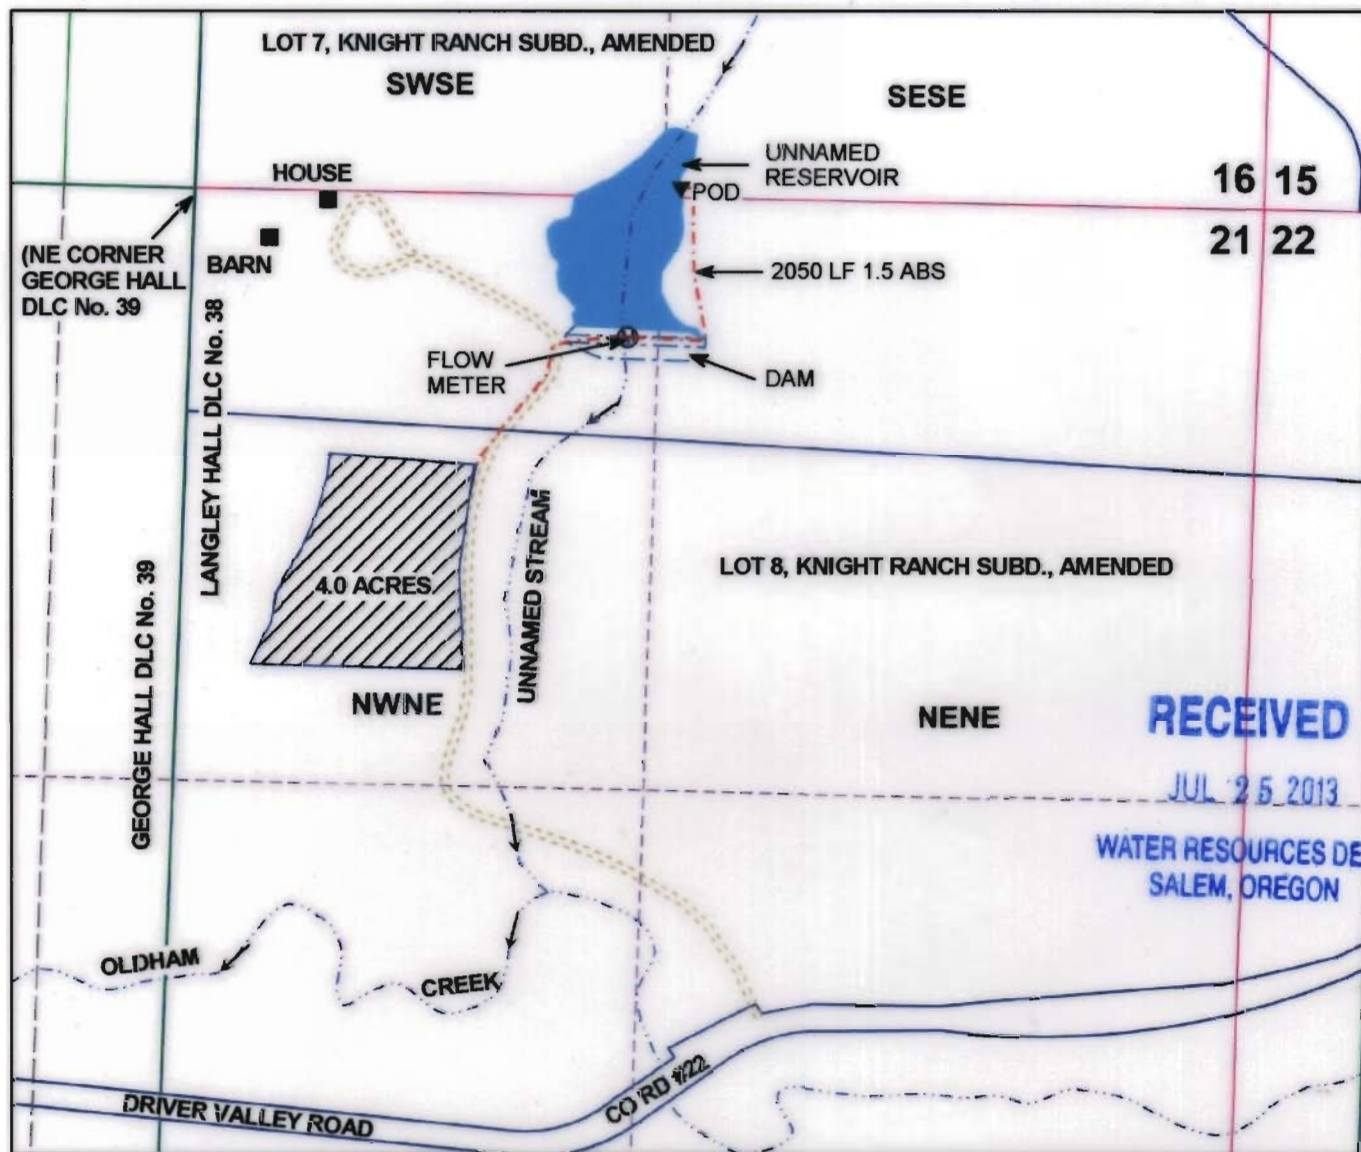

POD IS 27 FEET NORTH AND 1291 FEET WEST FROM NE COR SEC 21

Legend

Stream	PUMP	Roads	Section
Flow_arrow	Meter	structure	Quarter
Reservoir	Irrigation Area	Township	Sixteenth
POD	Pipeline	DLC	Parcels

THE PURPOSE OF THIS MAP IS TO IDENTIFY THE LOCATION OF THE WATER RIGHT. IT IS NOT INTENDED TO PROVIDE INFORMATION RELATIVE TO THE LOCATION OF PROPERTY OWNERSHIP BOUNDARY LINES.

MAP PREPARED FOR:
DALE & CARLEEN HOLLAND
P.O. BOX 89
7250 DRIVER VALLEY ROAD
OAKLAND, OR 97462

MAP PREPARED BY:
NATHAN R. REED, P.E., CWRE
1113 SE CASS AV
ROSEBURG, OR 97470