


T. 5N. R. 29E. W.M.

23

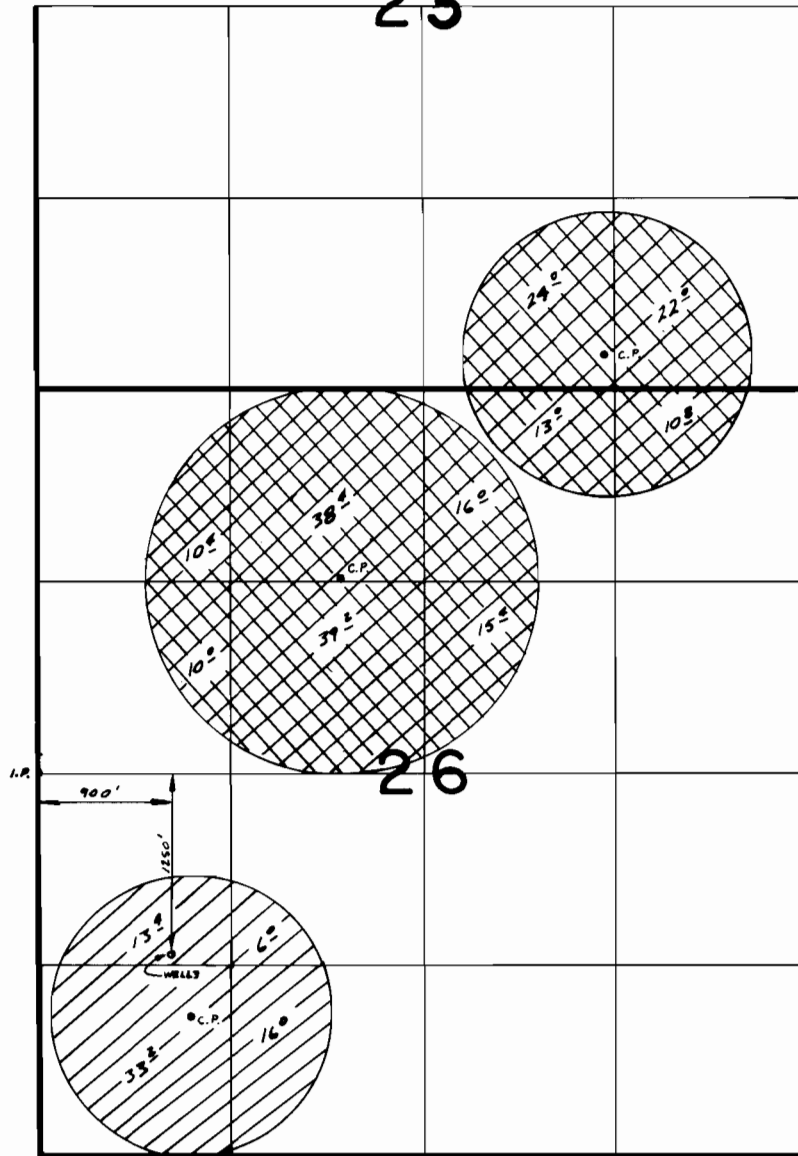

Superseded
9-26-84
GEC

FINAL PROOF SURVEY
UNDER

60172 45108
Application No. G-6910... Permit No. G-5699...
IN NAME OF



..... **L. J. & ALICE MARKS**

Surveyed 4-3..... 1978., by *R. BARWIN*.....