


T. 5N., R. 29E., W.M.

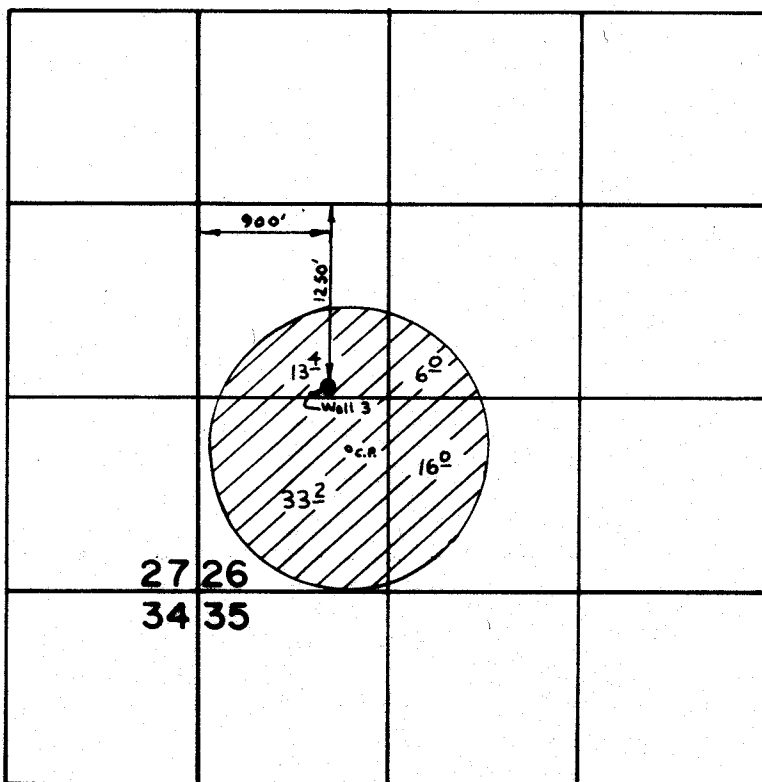

SCALE: 1" = 1320'

FINAL PROOF SURVEY UNDER

Application No. G-6910 Permit No. G-5699
IN NAME OF

L. J. & ALICE MARKS

Surveyed APR. 3 1978, by R. BARWIN

FL7-21 FL7-23

PTS-1978-P-A

V.L.C.

Traced 9-26-80 G.E.C.