


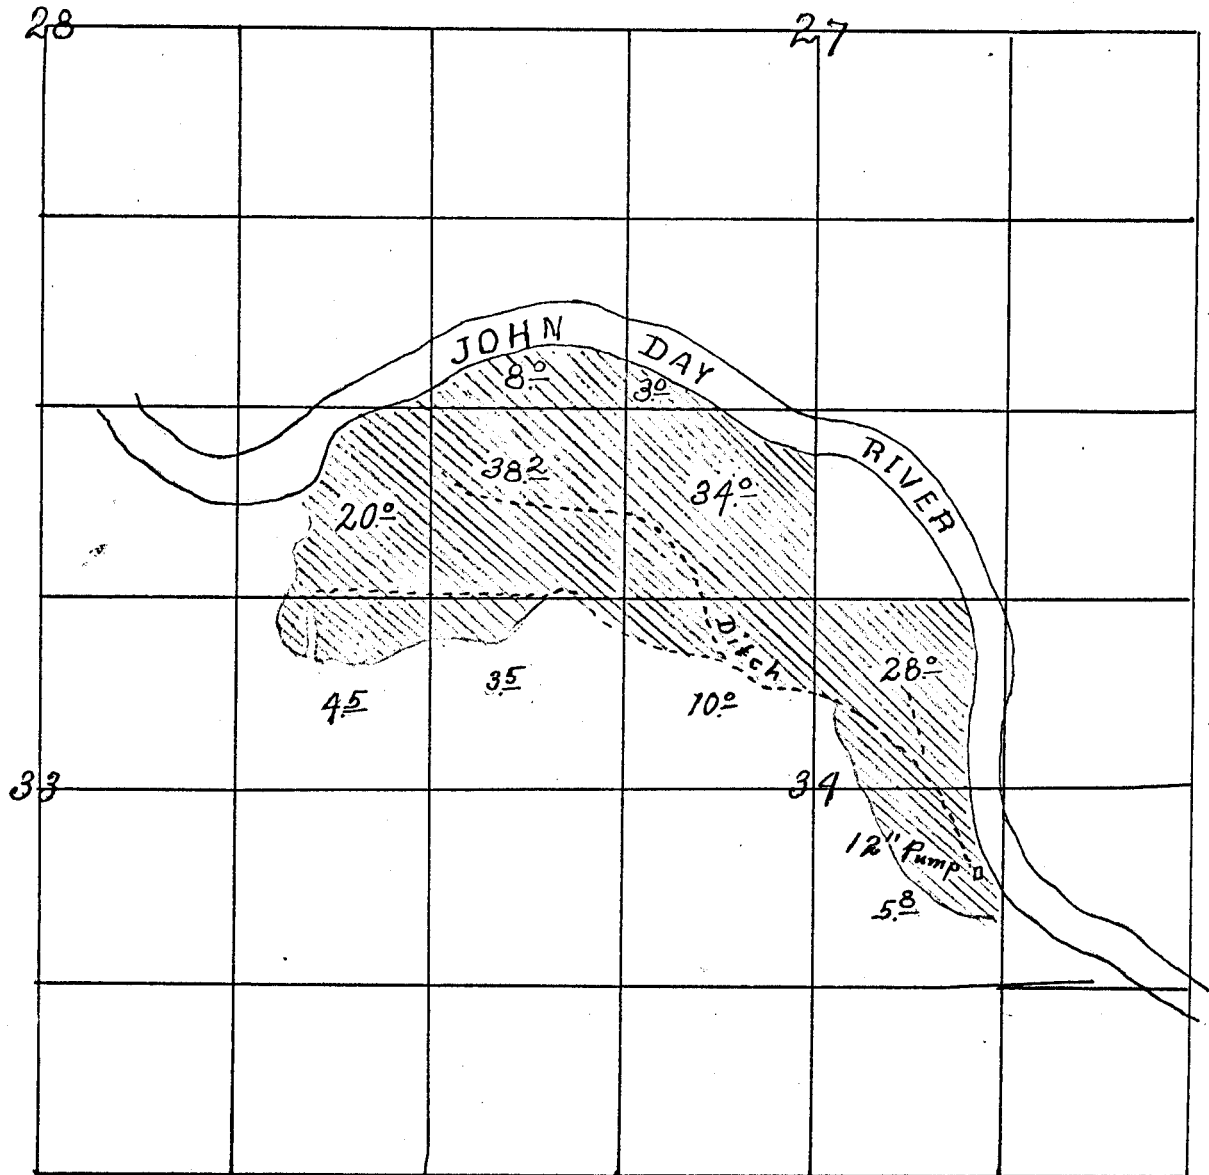

T. 9 S. R. 21 E

To accompany Application of Minnie E. Shown.

App 11528

Per 7963