




RECEIVED BY OWRD

**Legend**

 Township, Range, Section

*Authorized POD*


JAN 07 2013

*Twp Rng Sec 1/4 1/4  
1N 32E 27 SW SE*

SALEM, OR

*50ft North and 475ft East  
from South quarter corner  
of section 27*


RICHARD BANISTER  
43794 HOEFT RD.  
PENDLETON, OR 97801

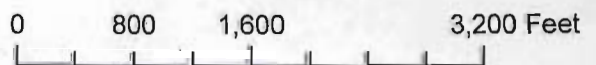

1 inch equals 1,320 feet



T. 1N., R. 32E., SEC. 22 & 27, W.M.

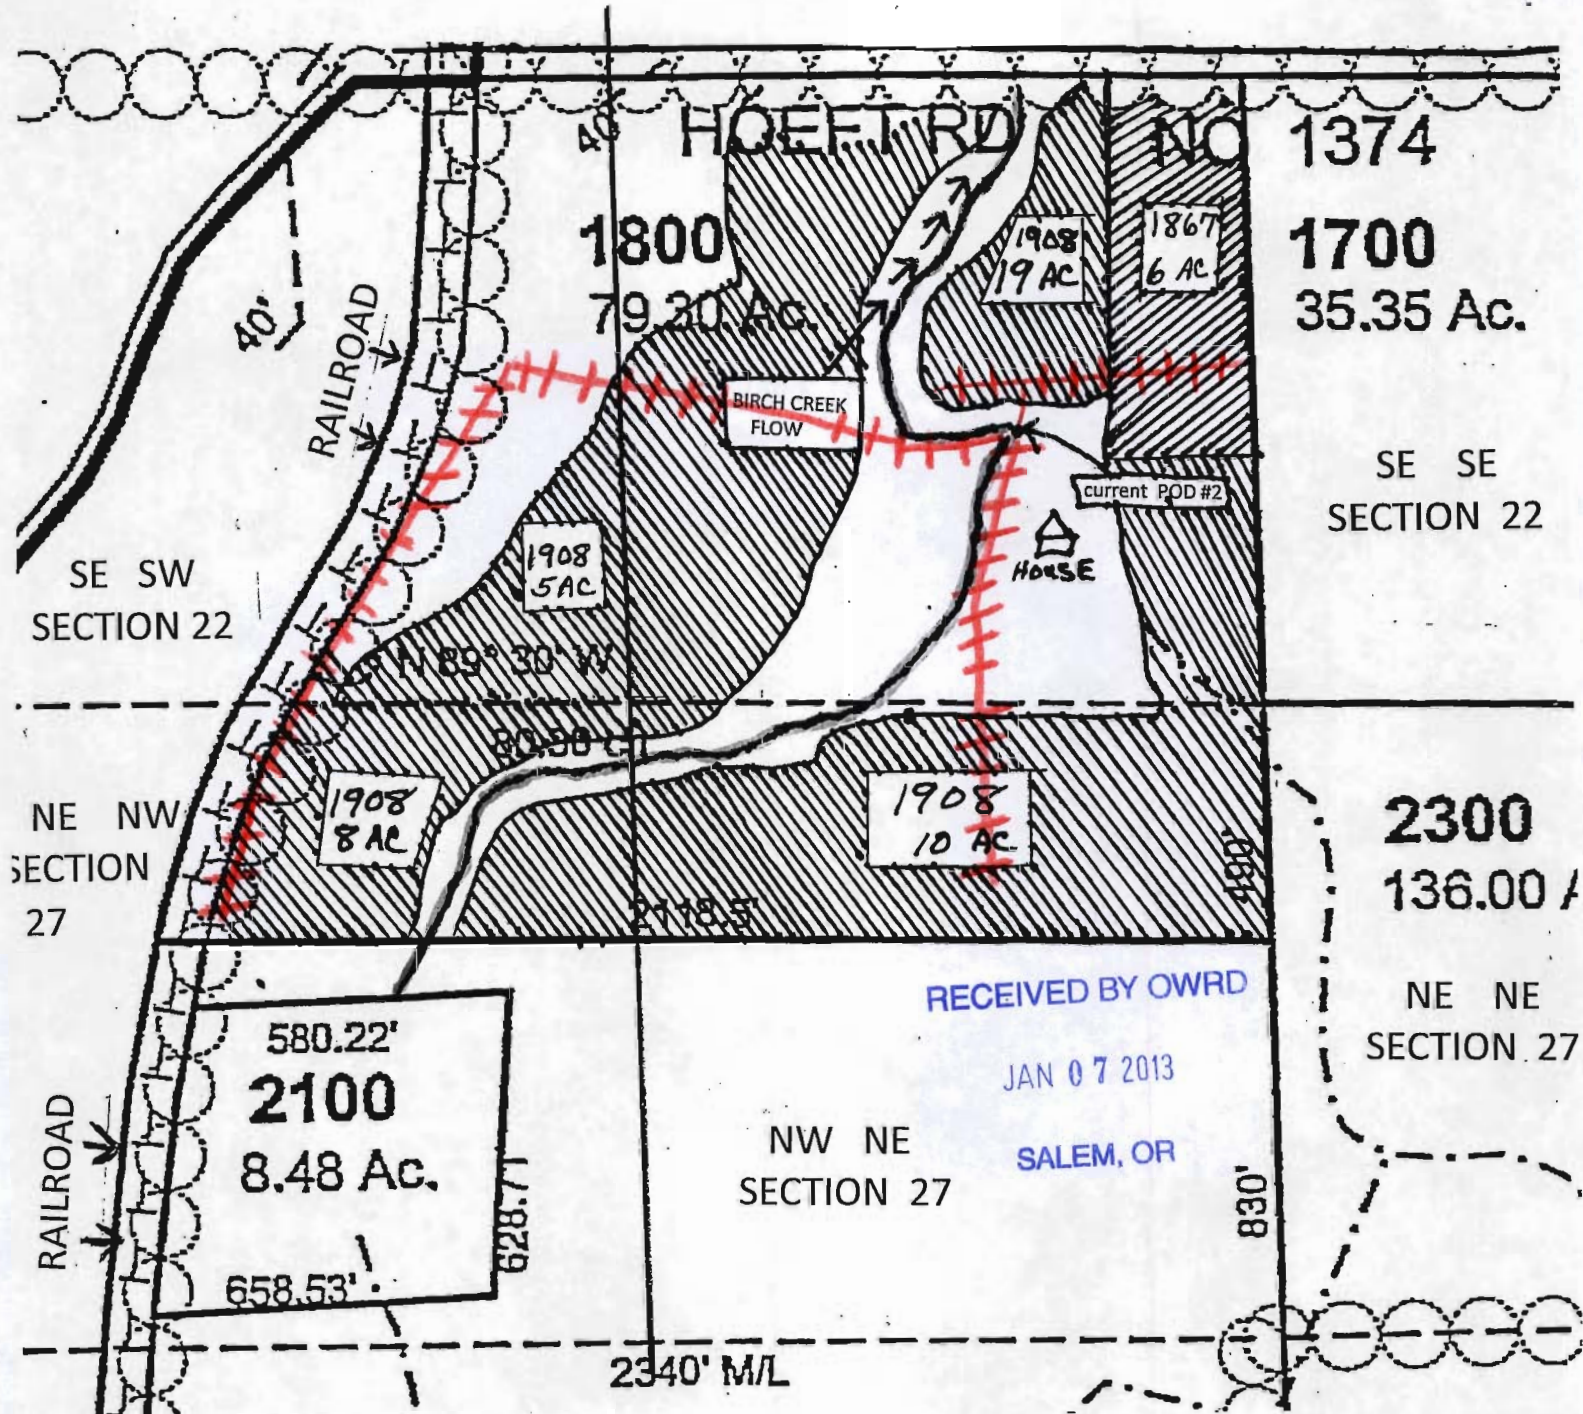

1374  
1700  
35.35 Ac.

SE SE SECTION 22

2300  
136.00 A

NE NE SECTION 27

NW NE SECTION 27

Authorized POD: 50' North and 475' East from the South 1/4 Corner of Section 27, being within the SW 1/4 SE 1/4, Section 27.  
(POD # 1)

Current POD: N 45.54576, -118.79408  
(POD # 2)  
670' North and 768' East from the South 1/4 Corner of Section 22, being within the SW 1/4 SE 1/4, Section 22.

Richard Banister  
43794 Hoeft Rd.  
Pendleton, Or 97801

Tax Lot 1800

Scale 1" = 400'



*Delivery system HHHH*