


T14S. R.39E. W.M.

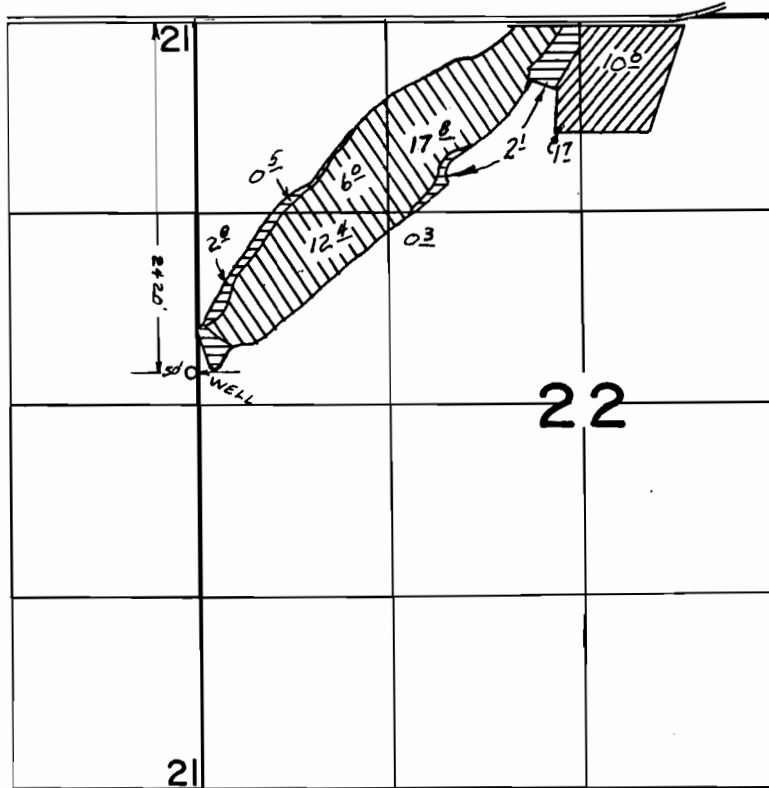

FINAL PROOF SURVEY UNDER

Application No. G-10636 Permit No. G-9926
 Application No. G-7094 Permit No. G-6562
 IN NAME OF

STEVE COLEMAN

AUG 23 1985 L.M. TOLL
 Surveyed JUN 23 1978, by L.H. NUNN

Suppl.



Primary
