


FINAL PROOF SURVEY
AND
CLAIM OF BENEFICIAL USE
ADDITIONAL POINT OF APPROPRIATION

LOCATED WITHIN
NW 1/4, NE 1/4 SECTION 18, T.3S., R.27E., W.M.,
MORROW COUNTY, OREGON
APPLICANT: MARY BEAMER - BEAMER RANCH

TRANSFER 9142

SPECIAL ORDER VOLUME 57, PAGE 306

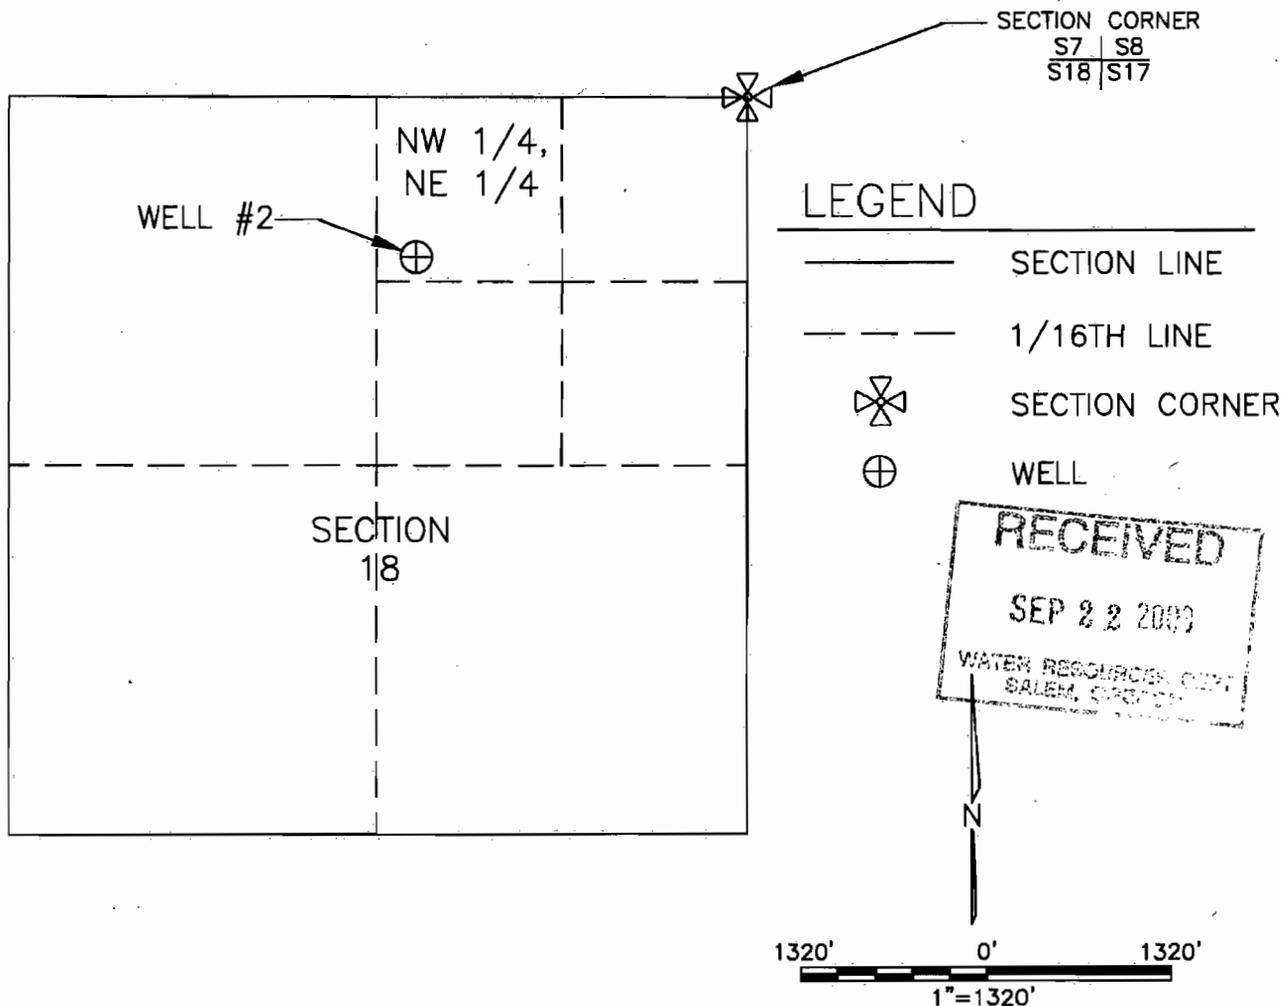


CORNER TIE:

WELL #2 IS WITHIN THE NW 1/4, NE 1/4, SECTION 18, T.3S., R.27E., W.M., AND IS 1,150' SOUTH AND 2,360' WEST OF THE NORTHEAST CORNER OF SECTION 18.

THIS MAP IS PREPARED FOR THE EXPRESS PURPOSE TO SHOW WATER APPROPRIATION AND USE. IT IS NOT INTENDED TO SHOW OR LOCATE PROPERTY OWNERSHIP LINES.

©

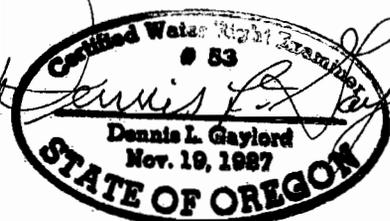

Renews 6/30/2005

DENNIS L. GAYLORD,
CWRE
71614 S.W. LAKE DRIVE
PENDLETON, OR 97801
(541)-276-6260
SEPTEMBER, 2003

Mill Creek Drafting


MAP TO ACCOMPANY WATER RIGHT TRANSFER
 ADDITIONAL POINT OF APPROPRIATION
 PERMIT G - 4315 CERTIFICATE 42529
 LOCATED WITHIN
 SECTIONS 7, 18 AND 19, T. 3 S., R. 27 E., W.M.
 MORROW COUNTY, OREGON
 APPLICANT: BEAMER RANCH

RECEIVED

JUN 06 2002

WATER RESOURCES DEPT.
 SALEM, OREGON

THIS MAP IS PREPARED FOR
 THE EXPRESS PURPOSE TO
 SHOW WATER APPROPRIATION
 AND USE. IT IS NOT INTENDED
 TO SHOW OR LOCATE
 PROPERTY OWNERSHIP LINES.

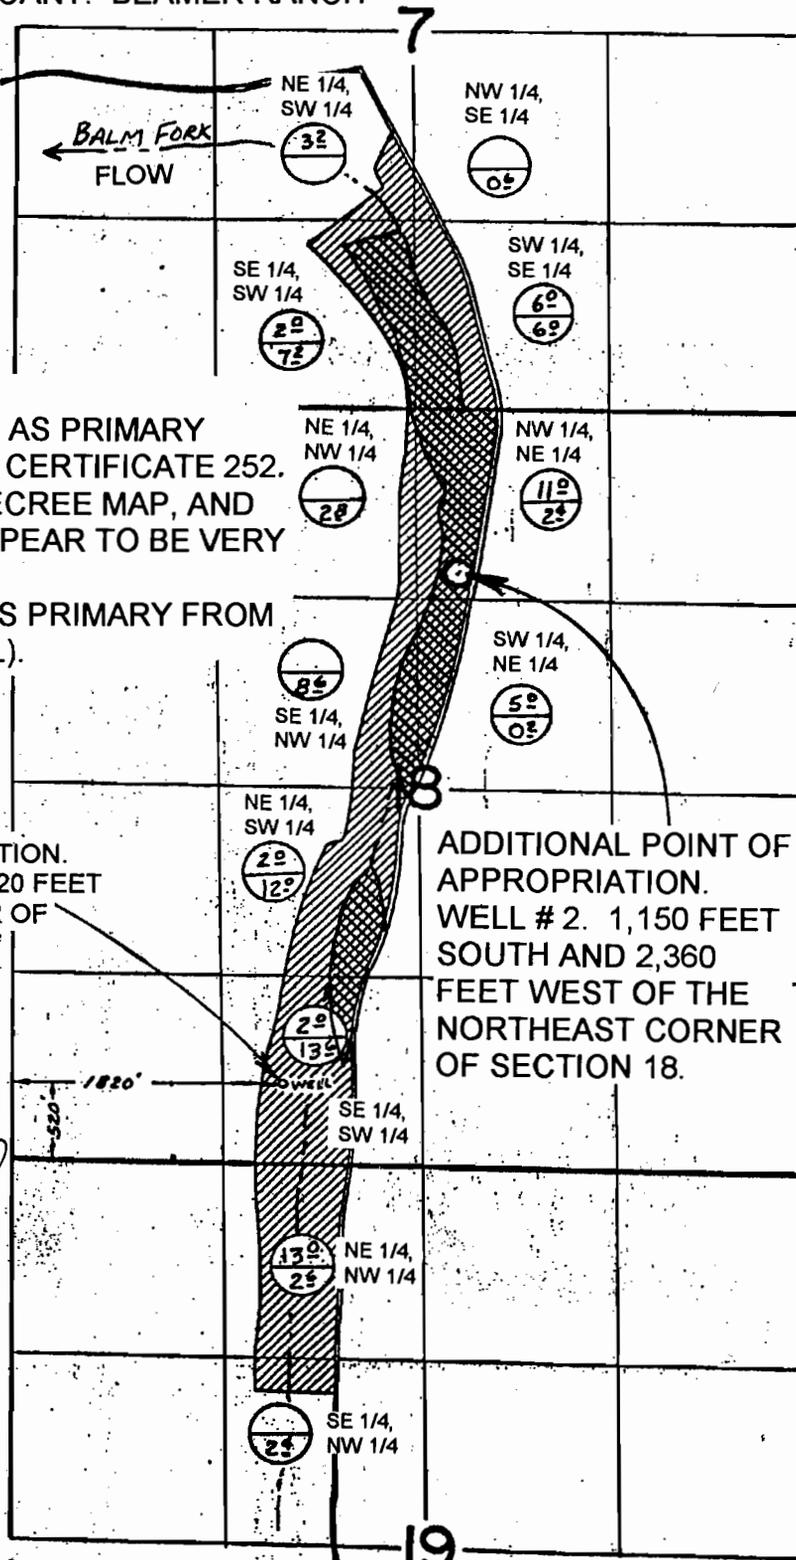

LEGEND

= AREA SHOWN ON DECREE MAP AS PRIMARY IRRIGATION FROM BALM FORK, CERTIFICATE 252. (NOT ALL IS SHOWN ON THE DECREE MAP, AND WHAT IS SHOWN DOES NOT APPEAR TO BE VERY ACCURATE).

= AREA ALSO IRRIGATED (MOST IS PRIMARY FROM WELL, SOME IS SUPPLEMENTAL).

- Supplemental
 - Primary

SCALE:
 1" = 1,320'

AUTHORIZED POINT OF APPROPRIATION.
 WELL # 1. 520 FEET NORTH AND 1,820 FEET
 EAST OF THE SOUTHWEST CORNER OF
 SECTION 18.

ADDITIONAL POINT OF APPROPRIATION.
 WELL # 2. 1,150 FEET
 SOUTH AND 2,360
 FEET WEST OF THE
 NORTHEAST CORNER
 OF SECTION 18.



RENEWS JUNE 30, 2003

DENNIS L. GAYLORD, CWRE
 71614 S.W. LAKE DRIVE
 PENDLETON, OR 97801
 541 - 276 - 6260
 MAY, 2002



T 9142