


T. 20S. R. 35 & 36E. W. M.

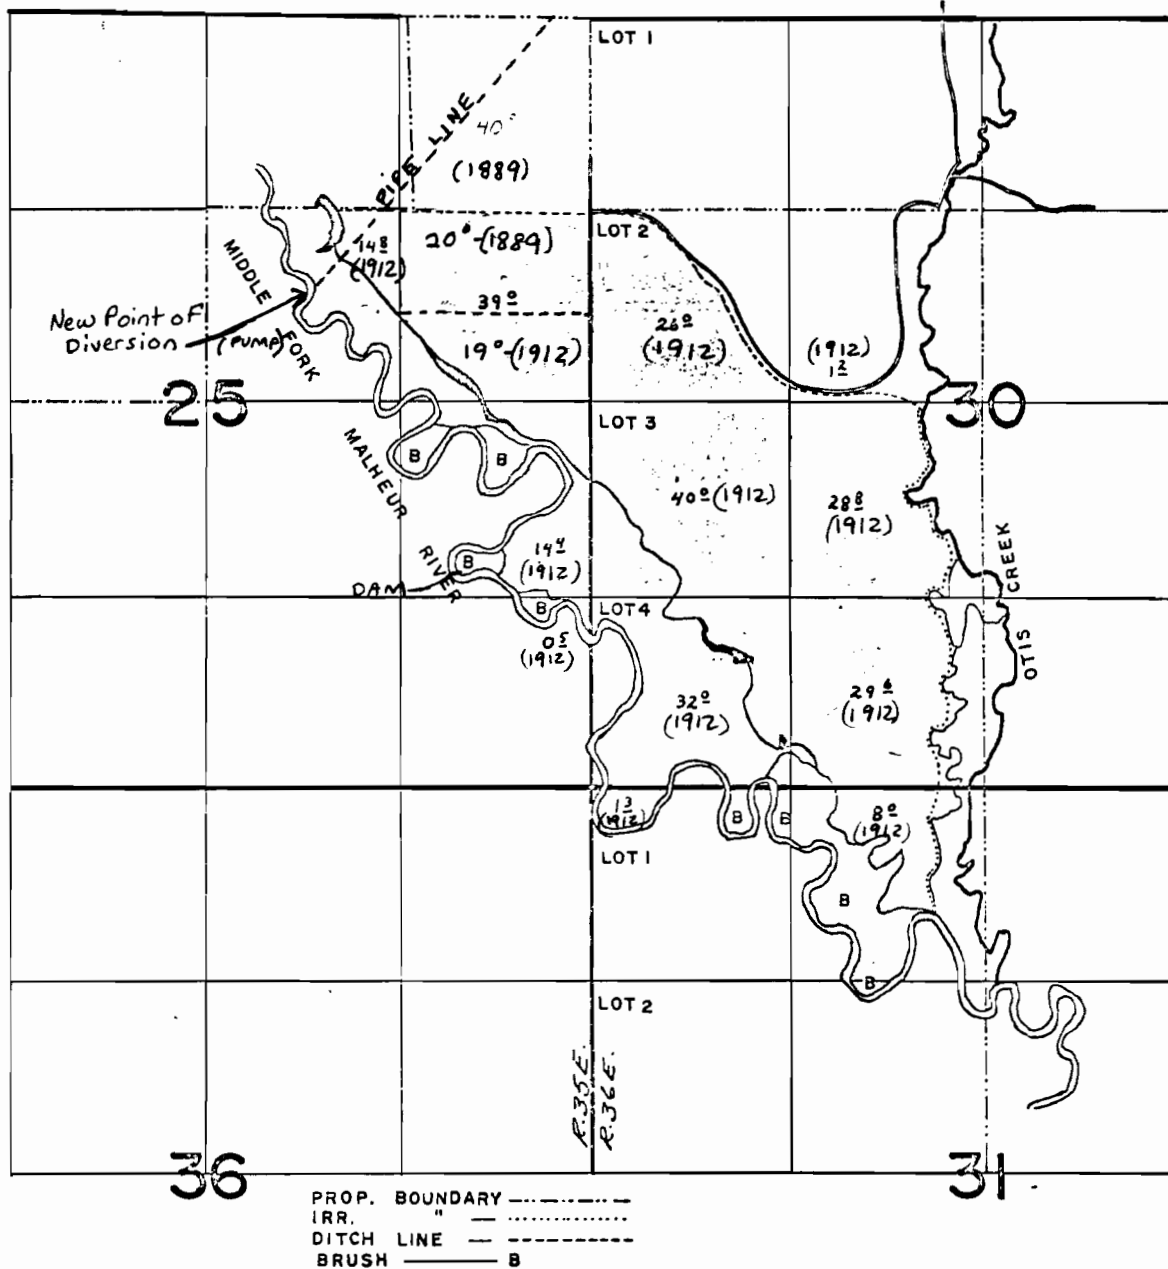

RECEIVED


DEC 16 1980

WATER RESOURCES DEPT
SALEM, OREGON

WATER RESOURCES DEPT
SALEM, OREGON


WATER RESOURCES DEPT
SALEM, OREGON

T. 20S. R. 35 & 36E. W. M.

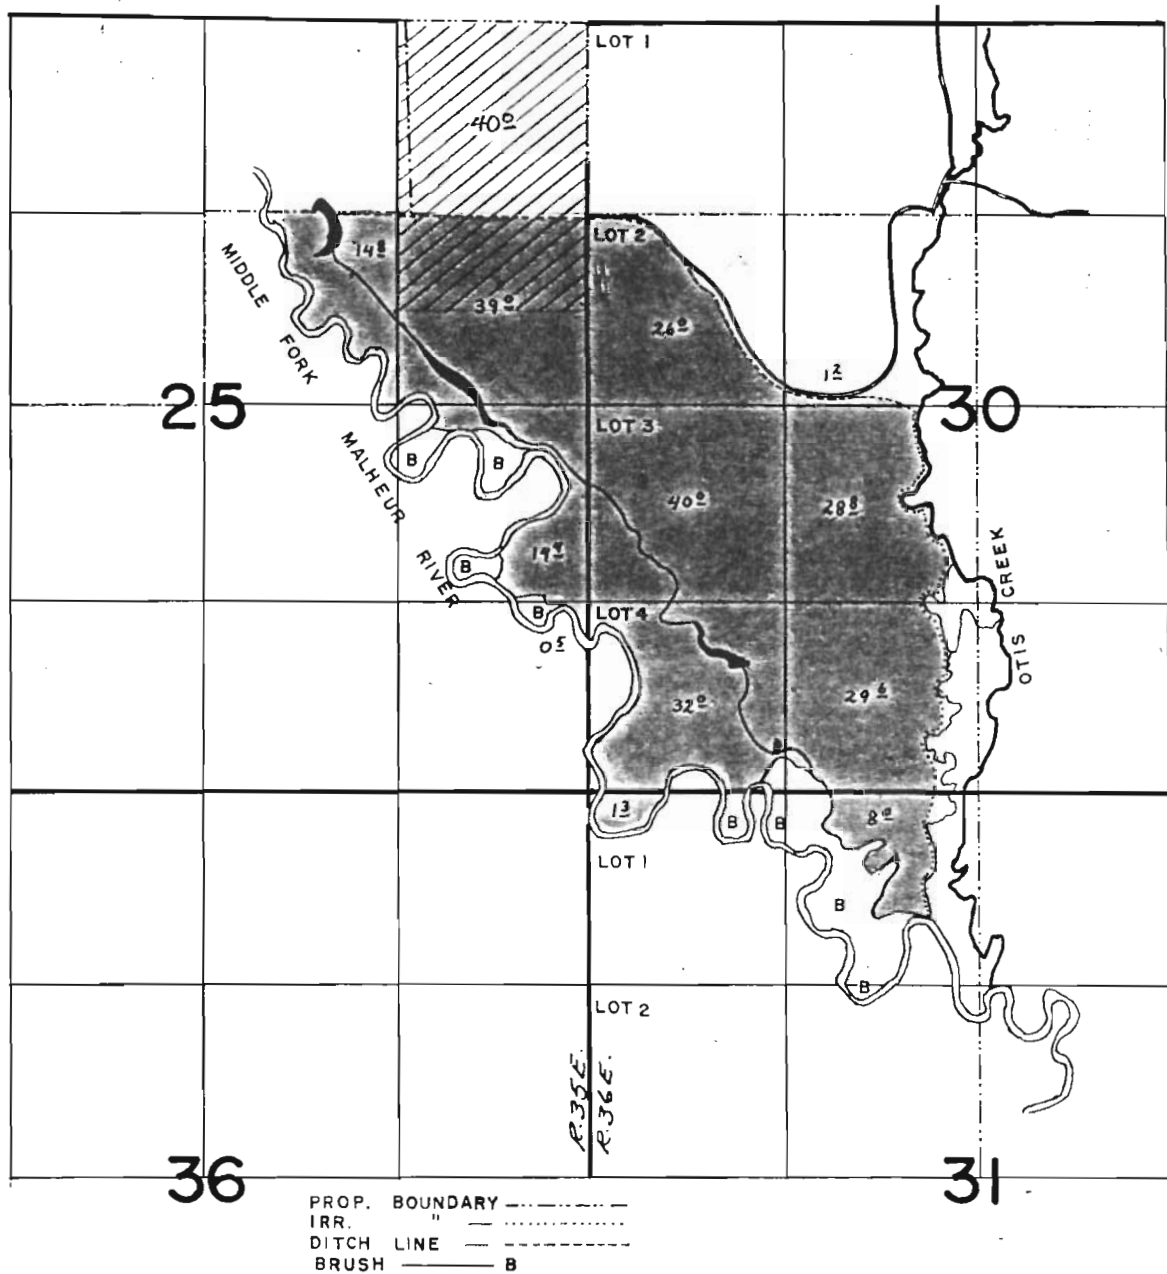

(FIGURE 2)

T. 20S., R. 35E., W.M.

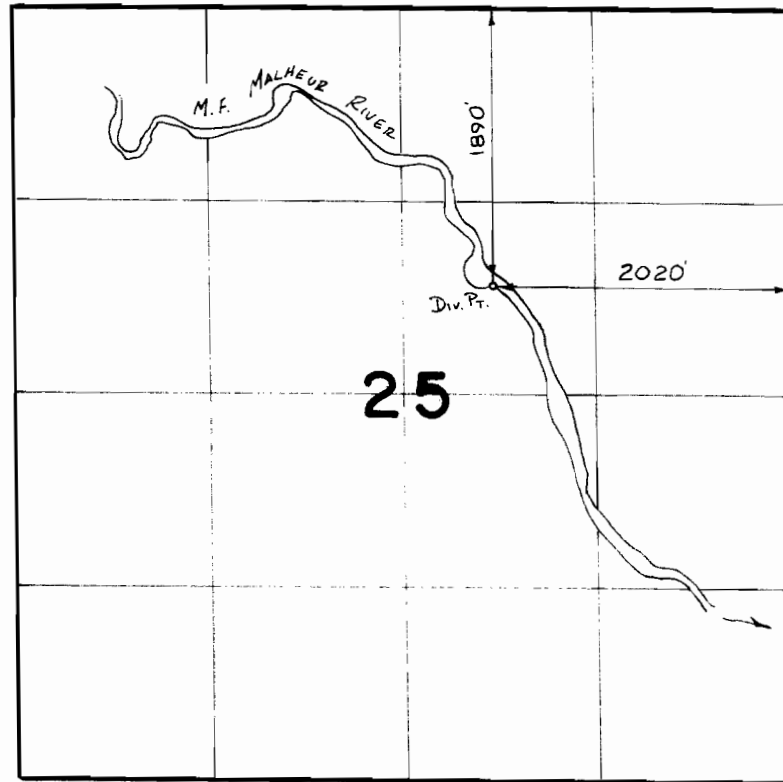

SCALE 1" = 1320'

FINAL PROOF SURVEY
UNDER

TRANSFER 4647
IN NAME OF

WRIGHT WILBUR

Surveyed 5-10 1988, by R.S. James