

CLAIM OF BENEFICIAL USE FINAL MAP

TRANSFER APPL.: T10077
CERTIFICATE: 57647

LOCATION:


Sec. 30, T29S, T14W, WM
COOS COUNTY, OREGON

OWNER:

BANDON CROSSING, LLC (CARLA C. SMITH)

POD:	STREAM:	LOCATION:
2	LOWER TWOMILE	1720' SOUTH, 2075' EAST from NW Cor Sec 30
3	UNNAMED	2045' SOUTH, 1775' EAST from NW Cor Sec 30


o = POD #8 FISH SCREEN & METER

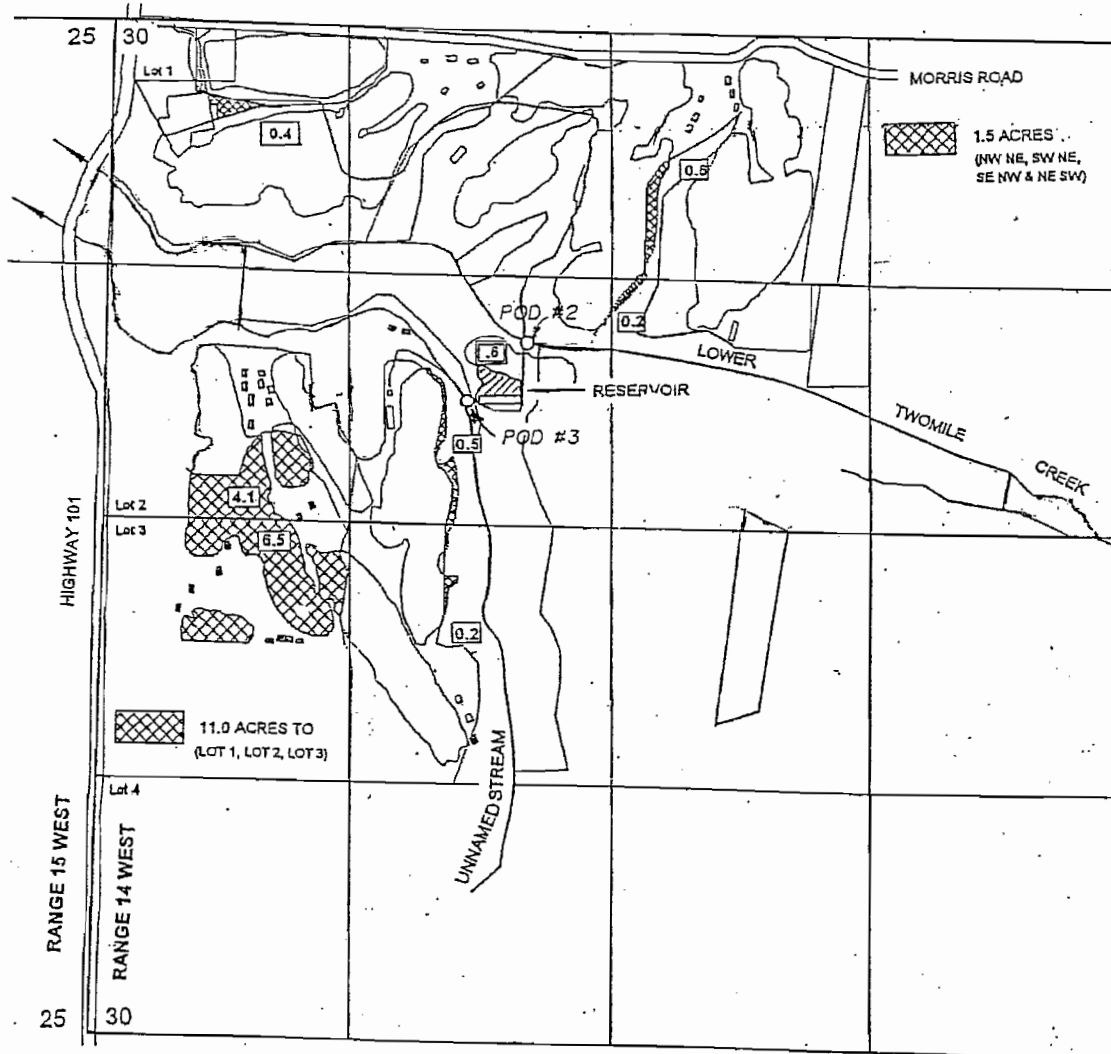

RECEIVED

JAN 14 2010

WATER RESOURCES DEPT
SALEM, OREGON

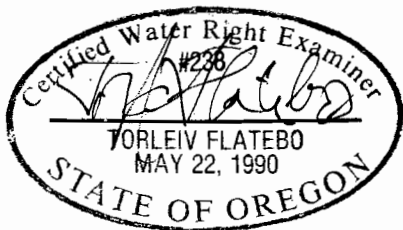

"This map is not intended to provide legal dimensions or locations of property ownership lines."