


HIAIT DITCH

W. E. and J. G. Hiott

Appropriators

Scale 1 in. = 660 feet.

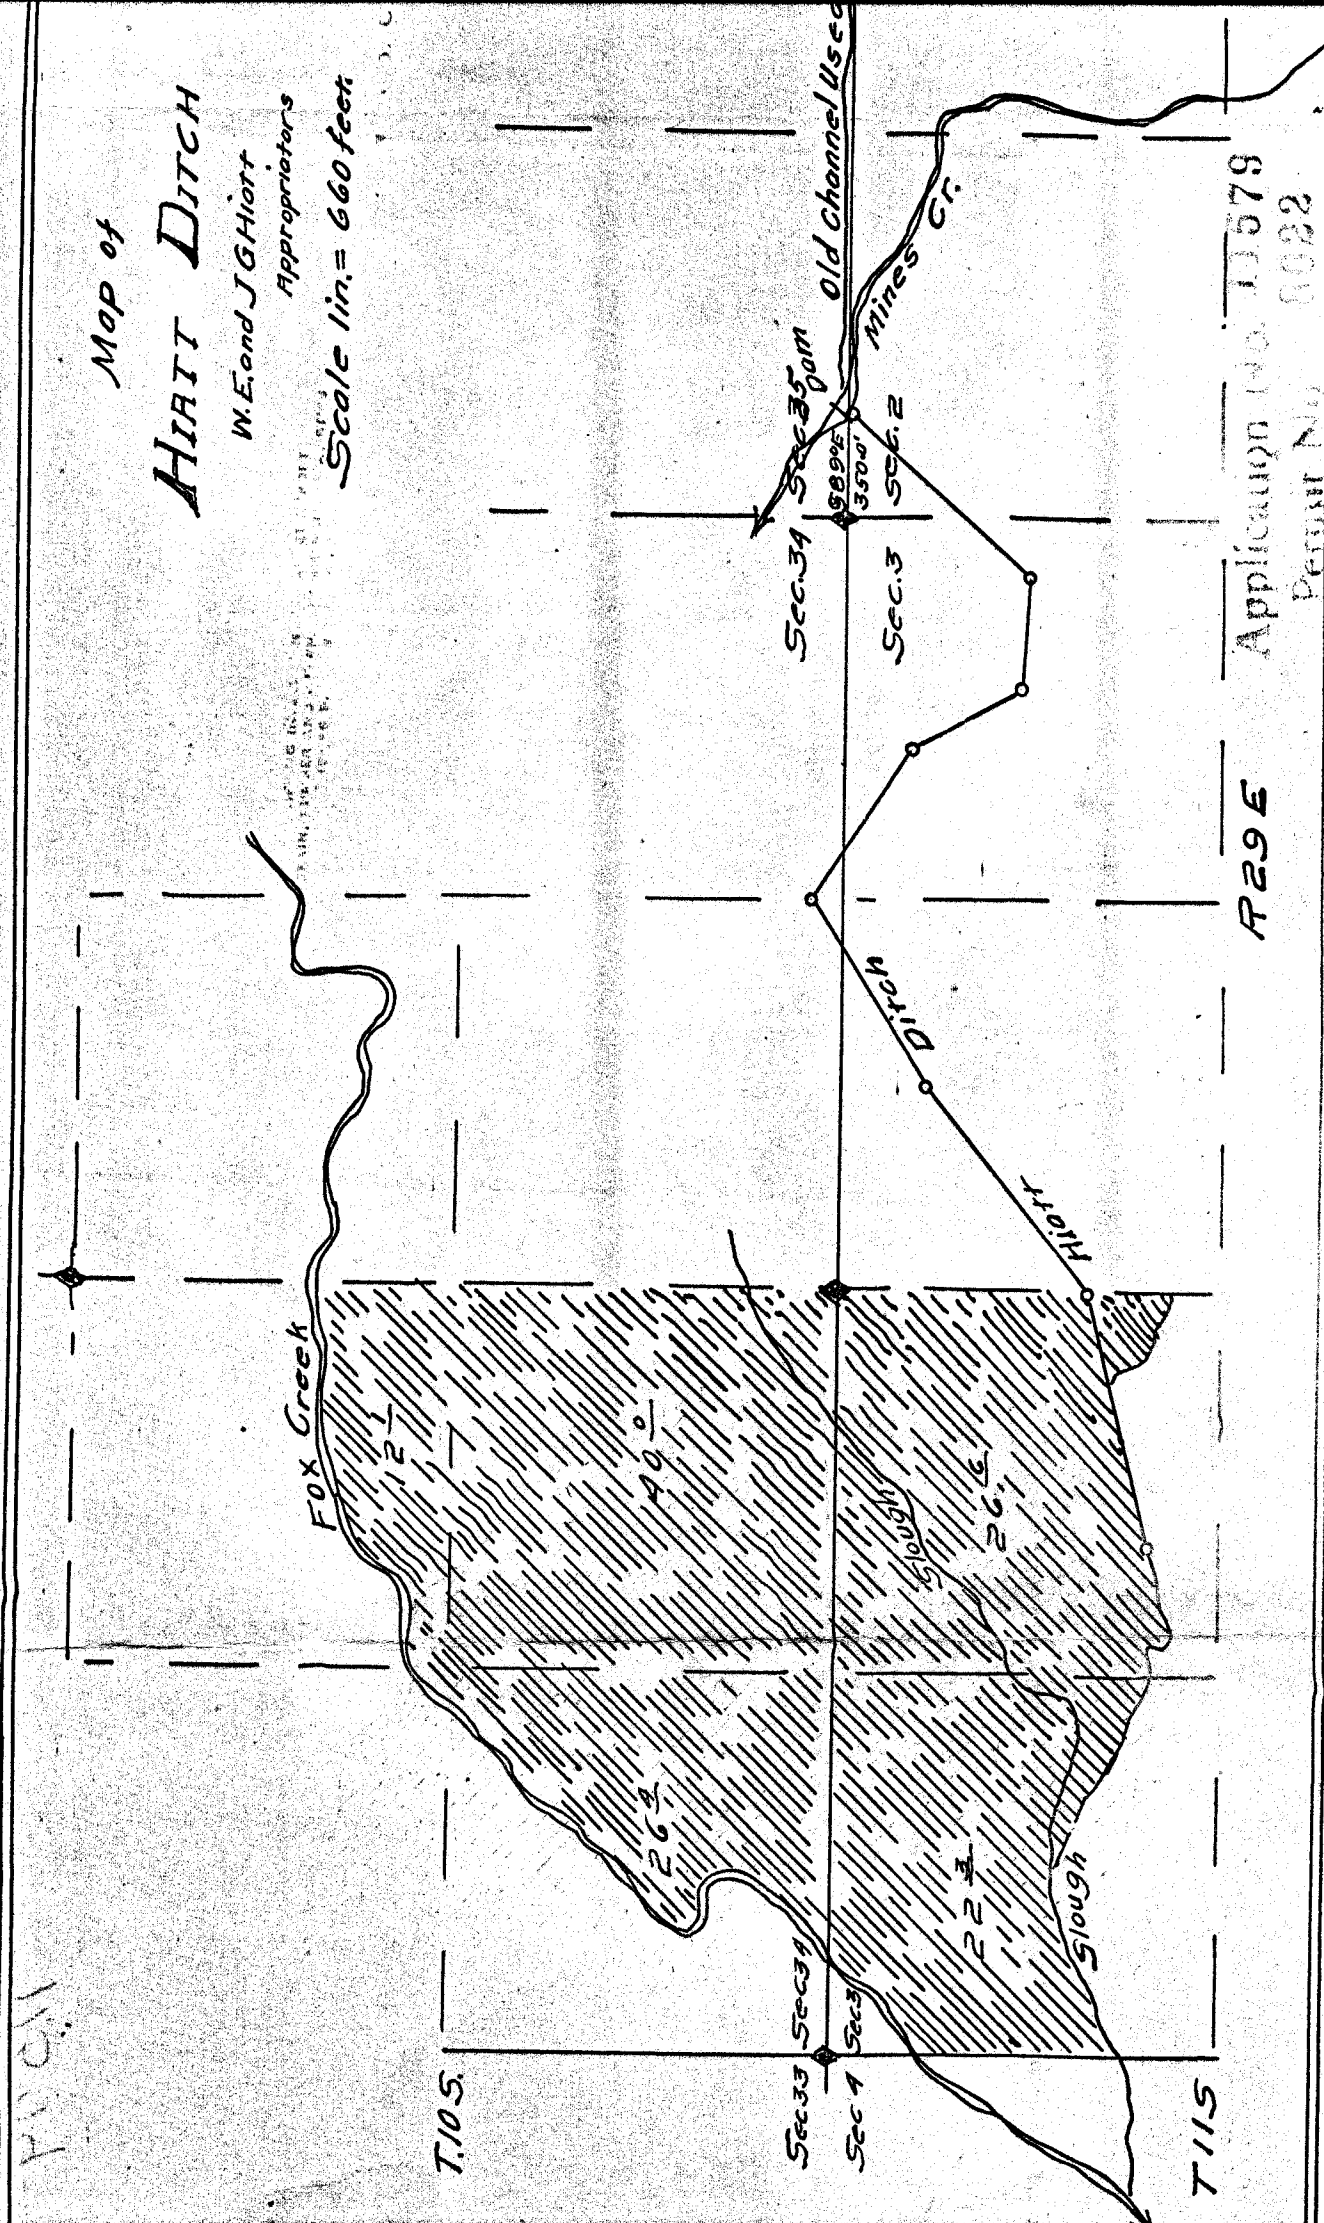

P29E

Applicant No. 11579

225

Map of



Appropriators

Scale 1 in. = 660 feet

Fox Creek

127

40°

Ditch


Sec. 34

Sec. 35

Sec. 3

Sec. 2

Old Channel Used as Ditch

Mines Cr.



Per # 8022
8903

P29E

Application No. 13578

Permit No. 8022


Sec.

Tr. 13 S.

R. 25 E.

Dis
NW Sec 2
148
24E

Per 8008
16018

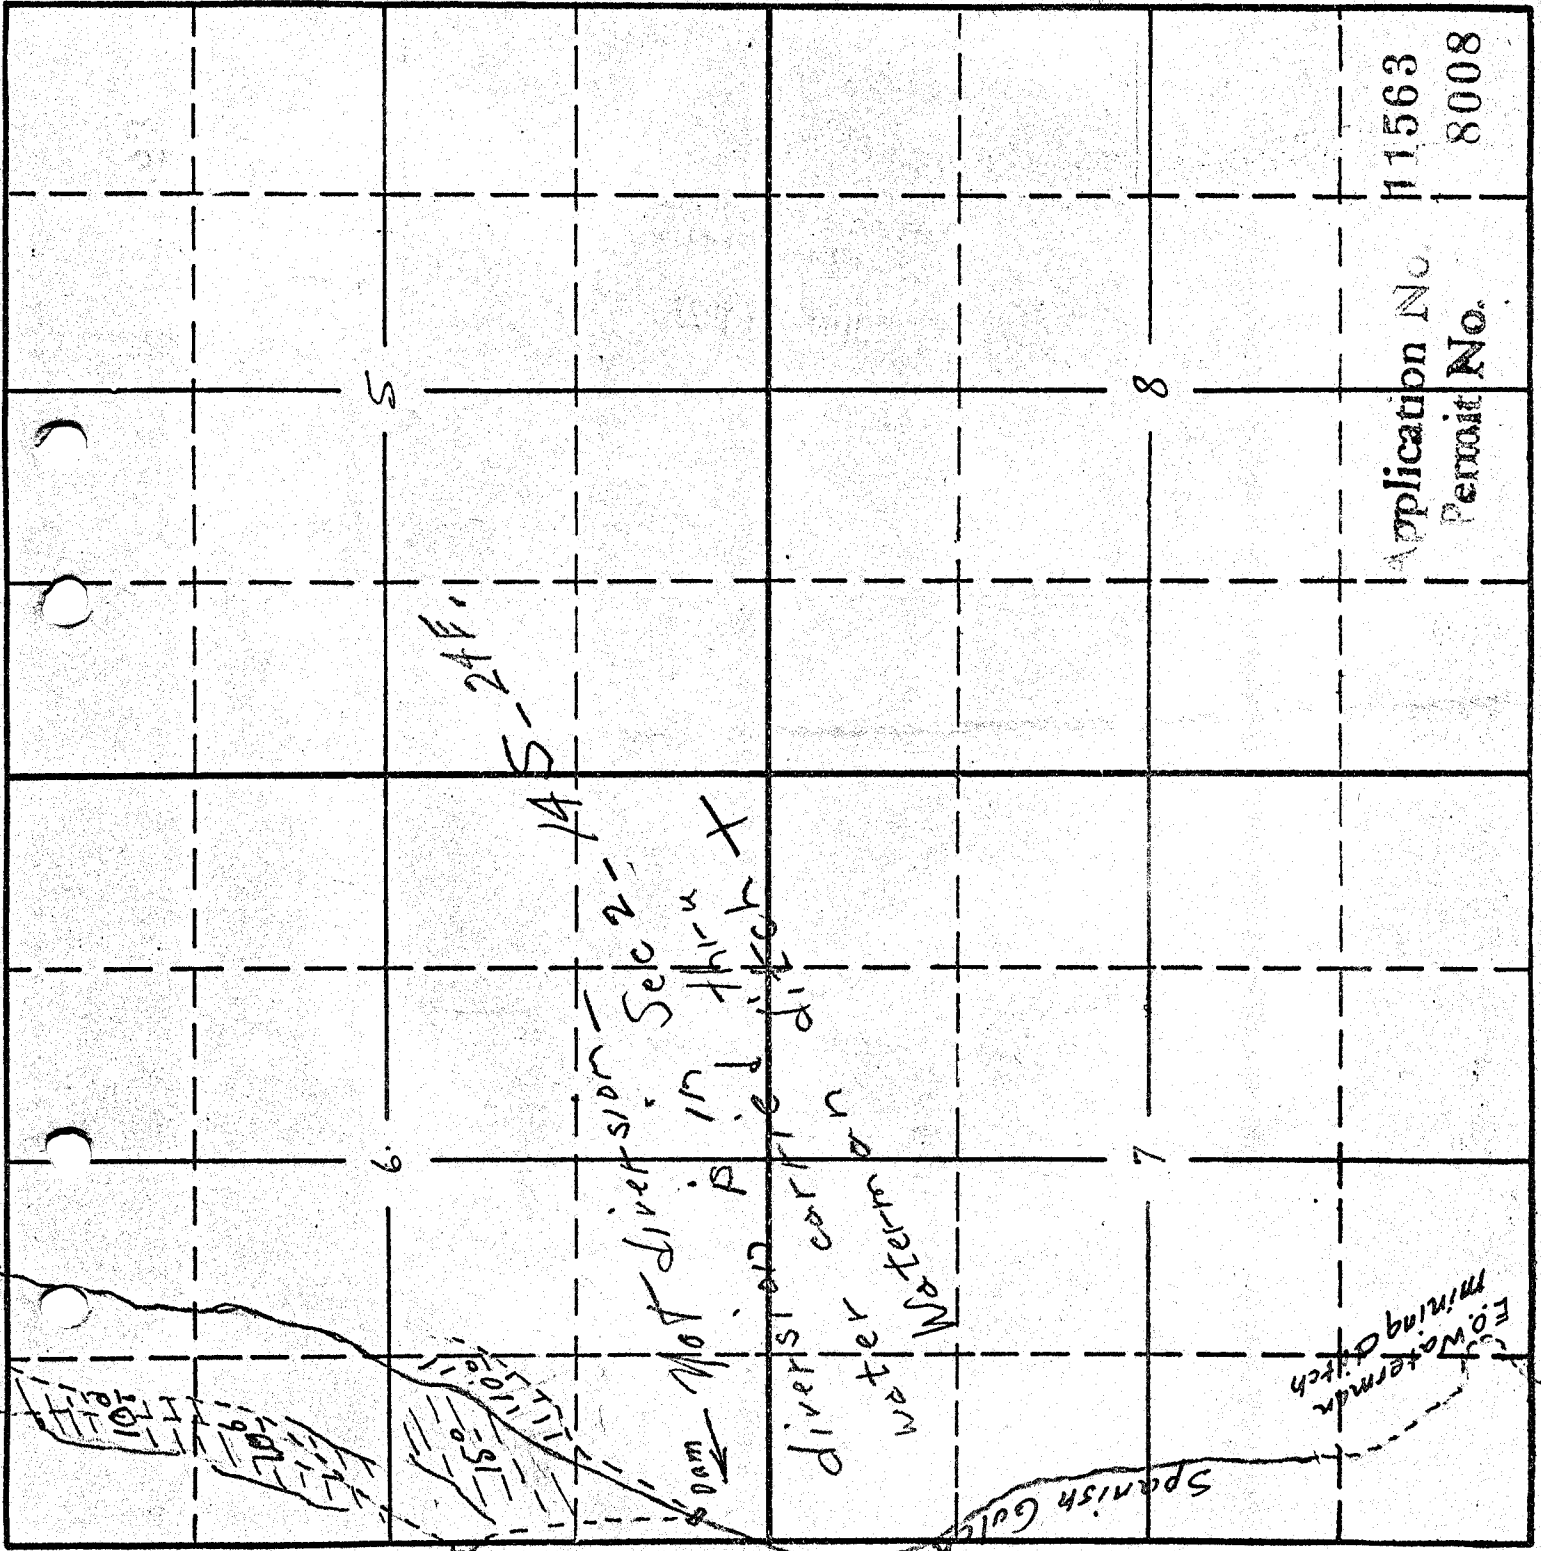

MAP
to accompany
Application
of

Paul H. Owens