


SECTIONS 32 AND 33,
 TOWNSHIP 1 S. RANGE 13 E. W.M.
 WASCO COUNTY, OREGON

SEP 28 1998

WATER RESOURCES DEPT.
 SALEM, OREGON

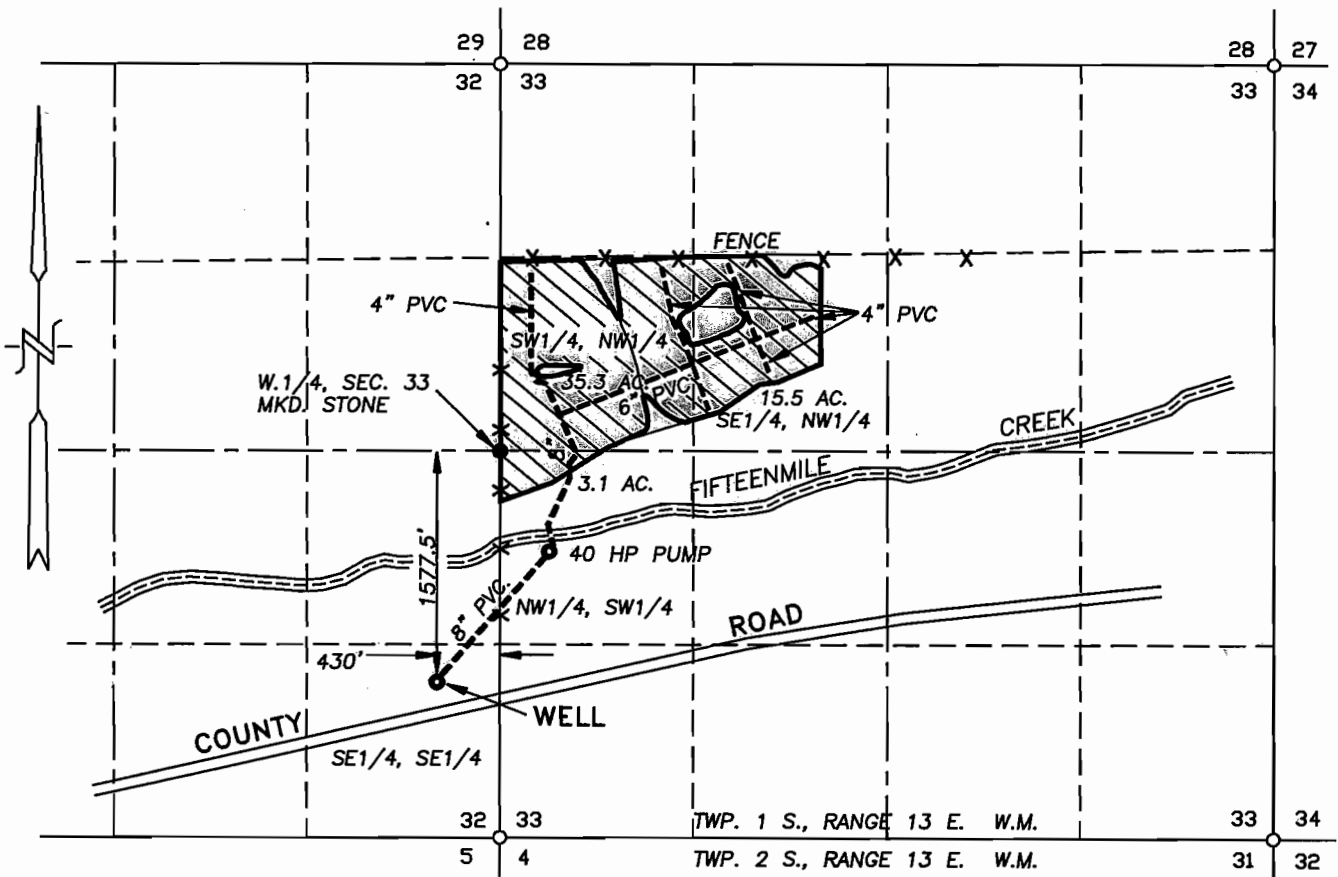

WELL LOCATED 1577.5' S. & 430' W. FROM
 THE W.1/4 CORNER, SECTION 33.

WATER RIGHT
FINAL PROOF SURVEY

SCALE: 1" = 1320'


APPLICATION No. G-12273

PERMIT No. G-11691

IN THE NAME OF:
D. PAUL SCHANNO, JR.

DATE: SEPTEMBER 22, 1998

BY: TENNESON ENGINEERING CORP.
 409 LINCOLN STREET,
 THE DALLES, OREGON. 97058
 PH: 541-296-9177
 FAX 541-296-6657

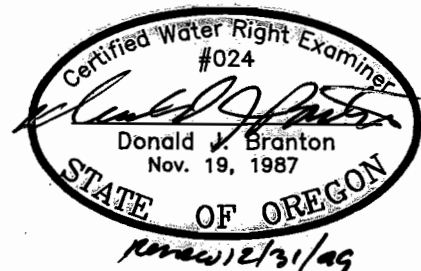

NOTE:

"THIS MAP IDENTIFIES THE LOCATION OF
 THE WATER RIGHT ONLY AND IS NOT
 INTENDED TO PROVIDE DIMENSIONS OR
 LOCATE PROPERTY OWNERSHIP LINES."

W.O. #7326A