


T. 17 S., R. 22 E., W.M.

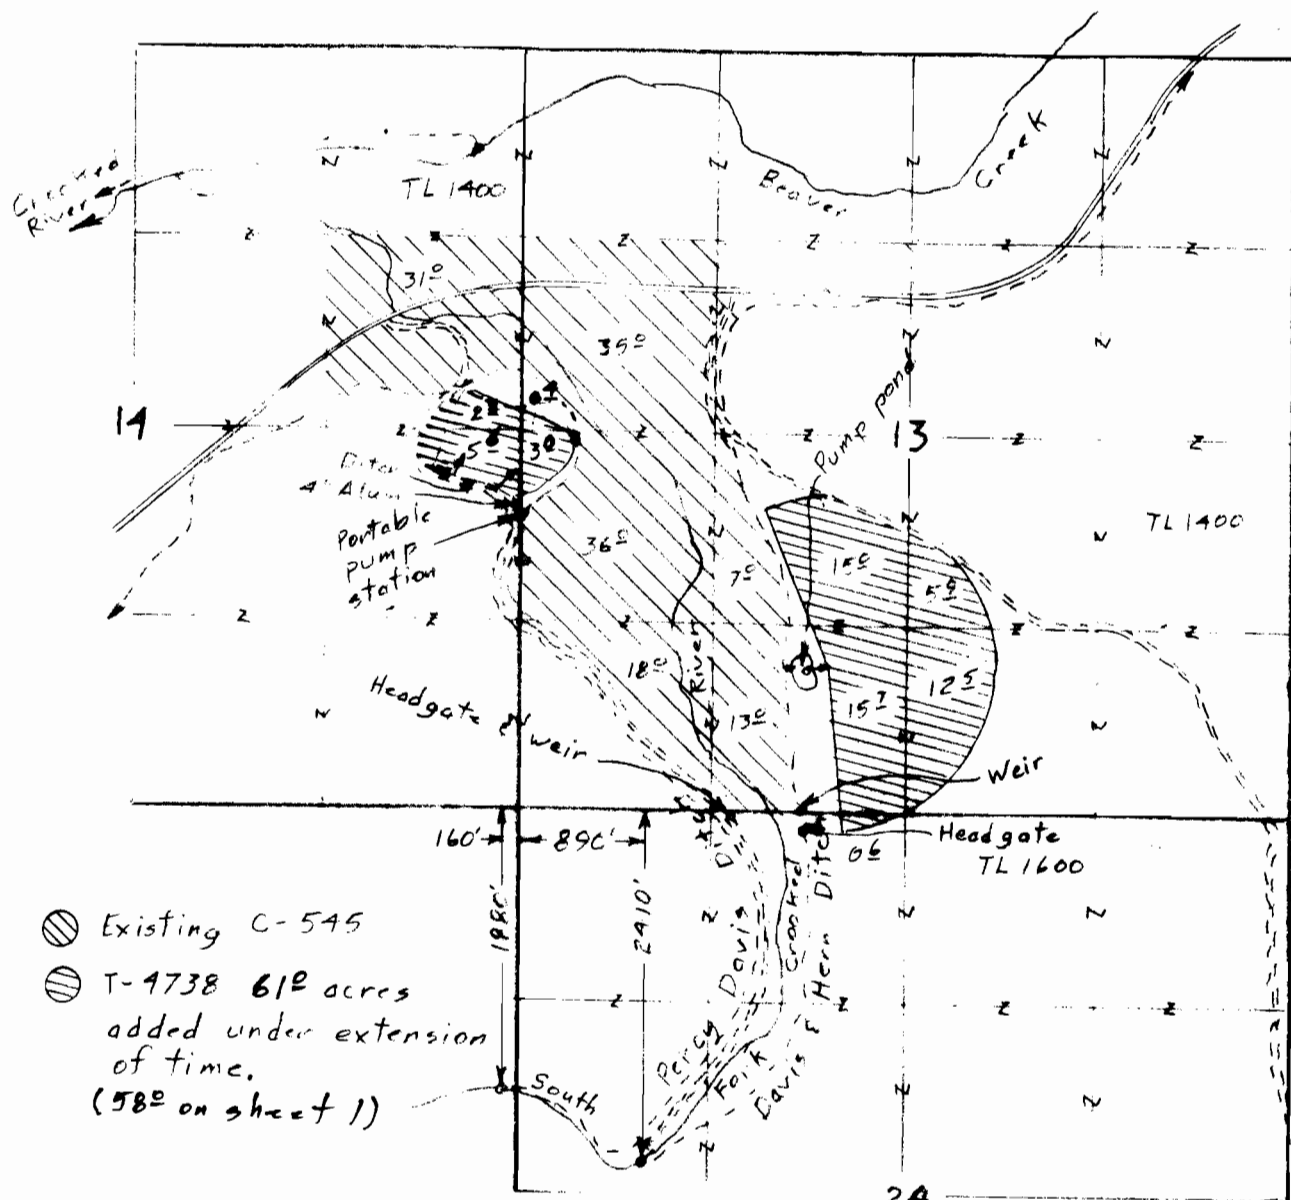


Scale
1" = 1320'
(4" = 1 mile)

- ⊘ Existing C-545
- ⊘ T-4738 612 acres added under extension of time. (58° on sheet 1)

Surveyed July 5, 2013 & July 25, 2013

T-4738

Claim of Beneficial Use Map for Twin Buttes Ranch (Oregon Ranching, Inc.)

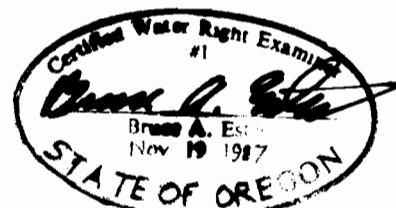

Renewal Dec 31 2013 Sheet 2 of 2

RECEIVED BY: [Signature]


This map is for the purpose of locating a water right only and has no intent to provide legal dimensions or the location of property lines.

ESTES SURVEYS, LLC

PO Box 17540
Salem, OR 97305-7540
(503) 586-7698

60387 Arnold Rd
Bend, OR 97702
(541) 382-7381

T.17 S., R.22 E., W.M.

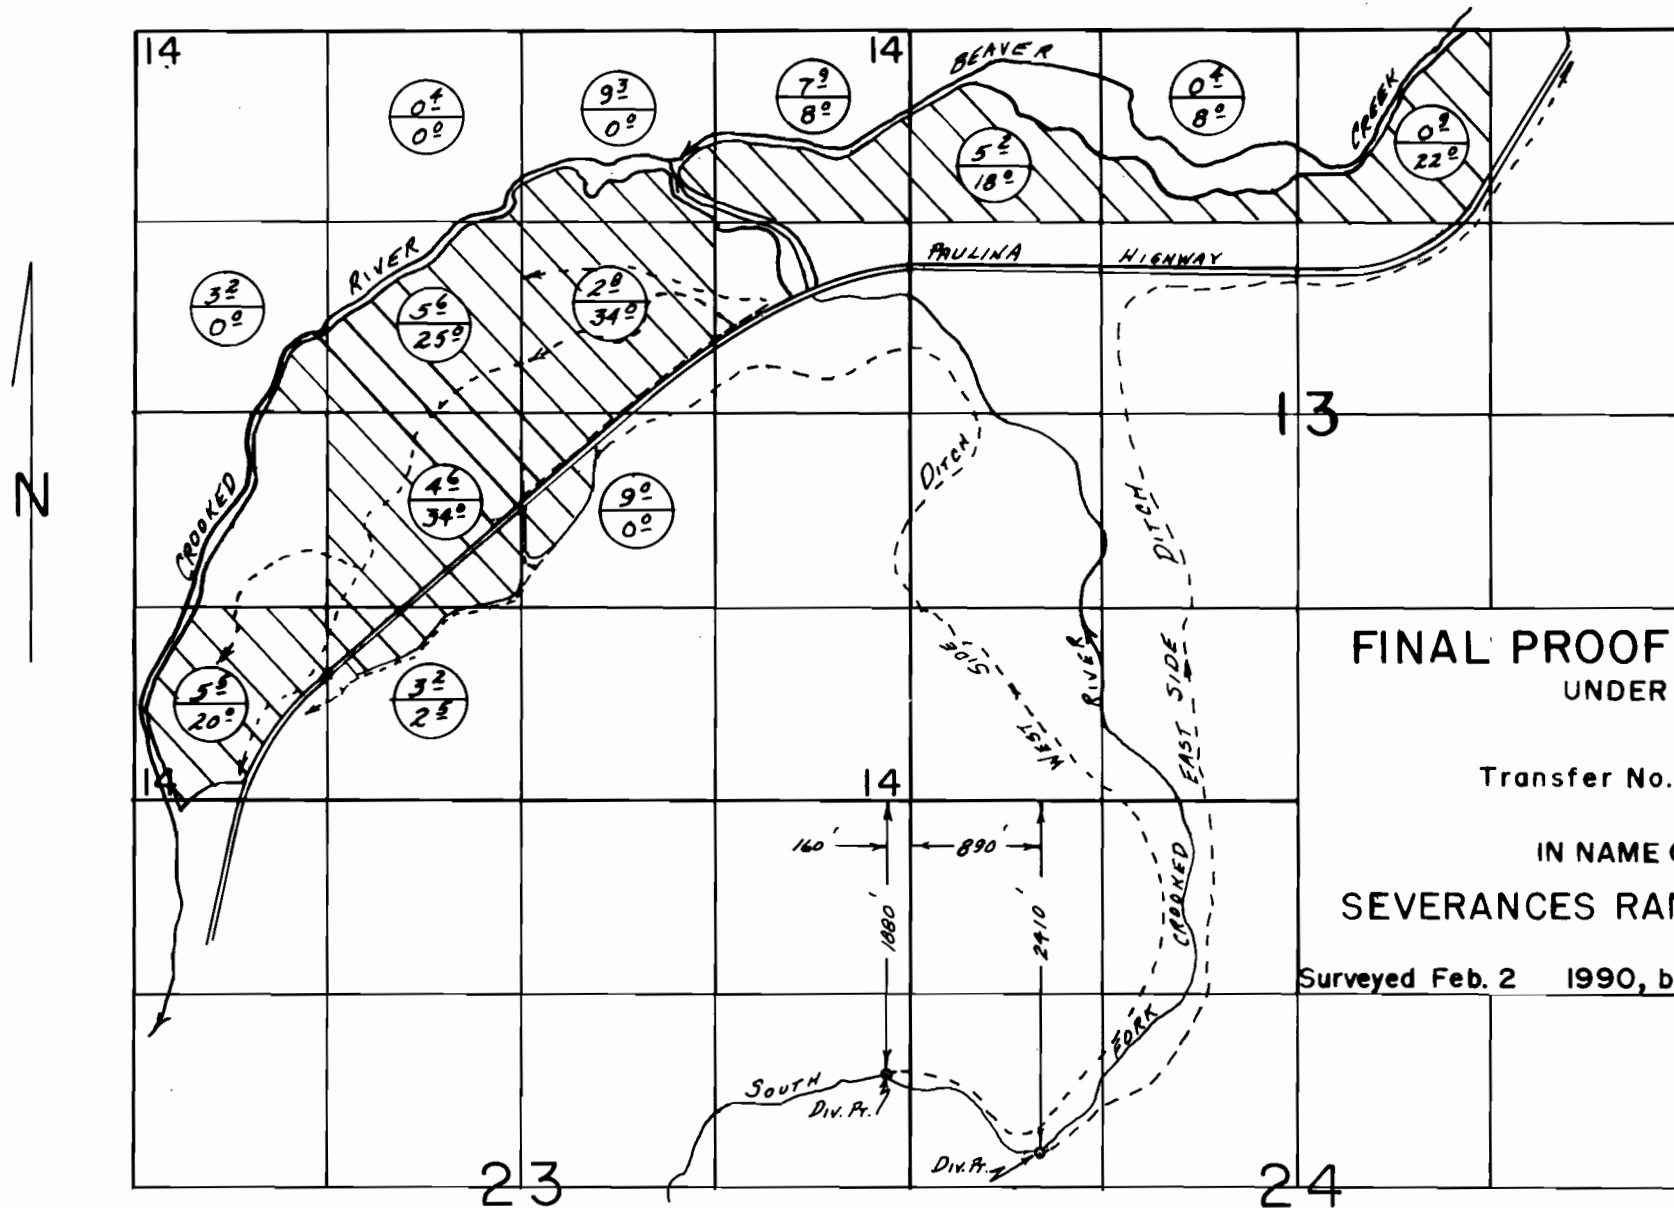

FINAL PROOF SURVEY
UNDER

Transfer No. 4738

IN NAME OF
SEVERANCES RANCH, INC.

Surveyed Feb. 2 1990, by B.W. BISHOP

Tr. 4738
Cert. 545

Scale: 1"=1320'

1/3/91
41013-280-81D B.W.B.