





TOWNSHIP 17 SOUTH, RANGE 22 EAST, W.M.

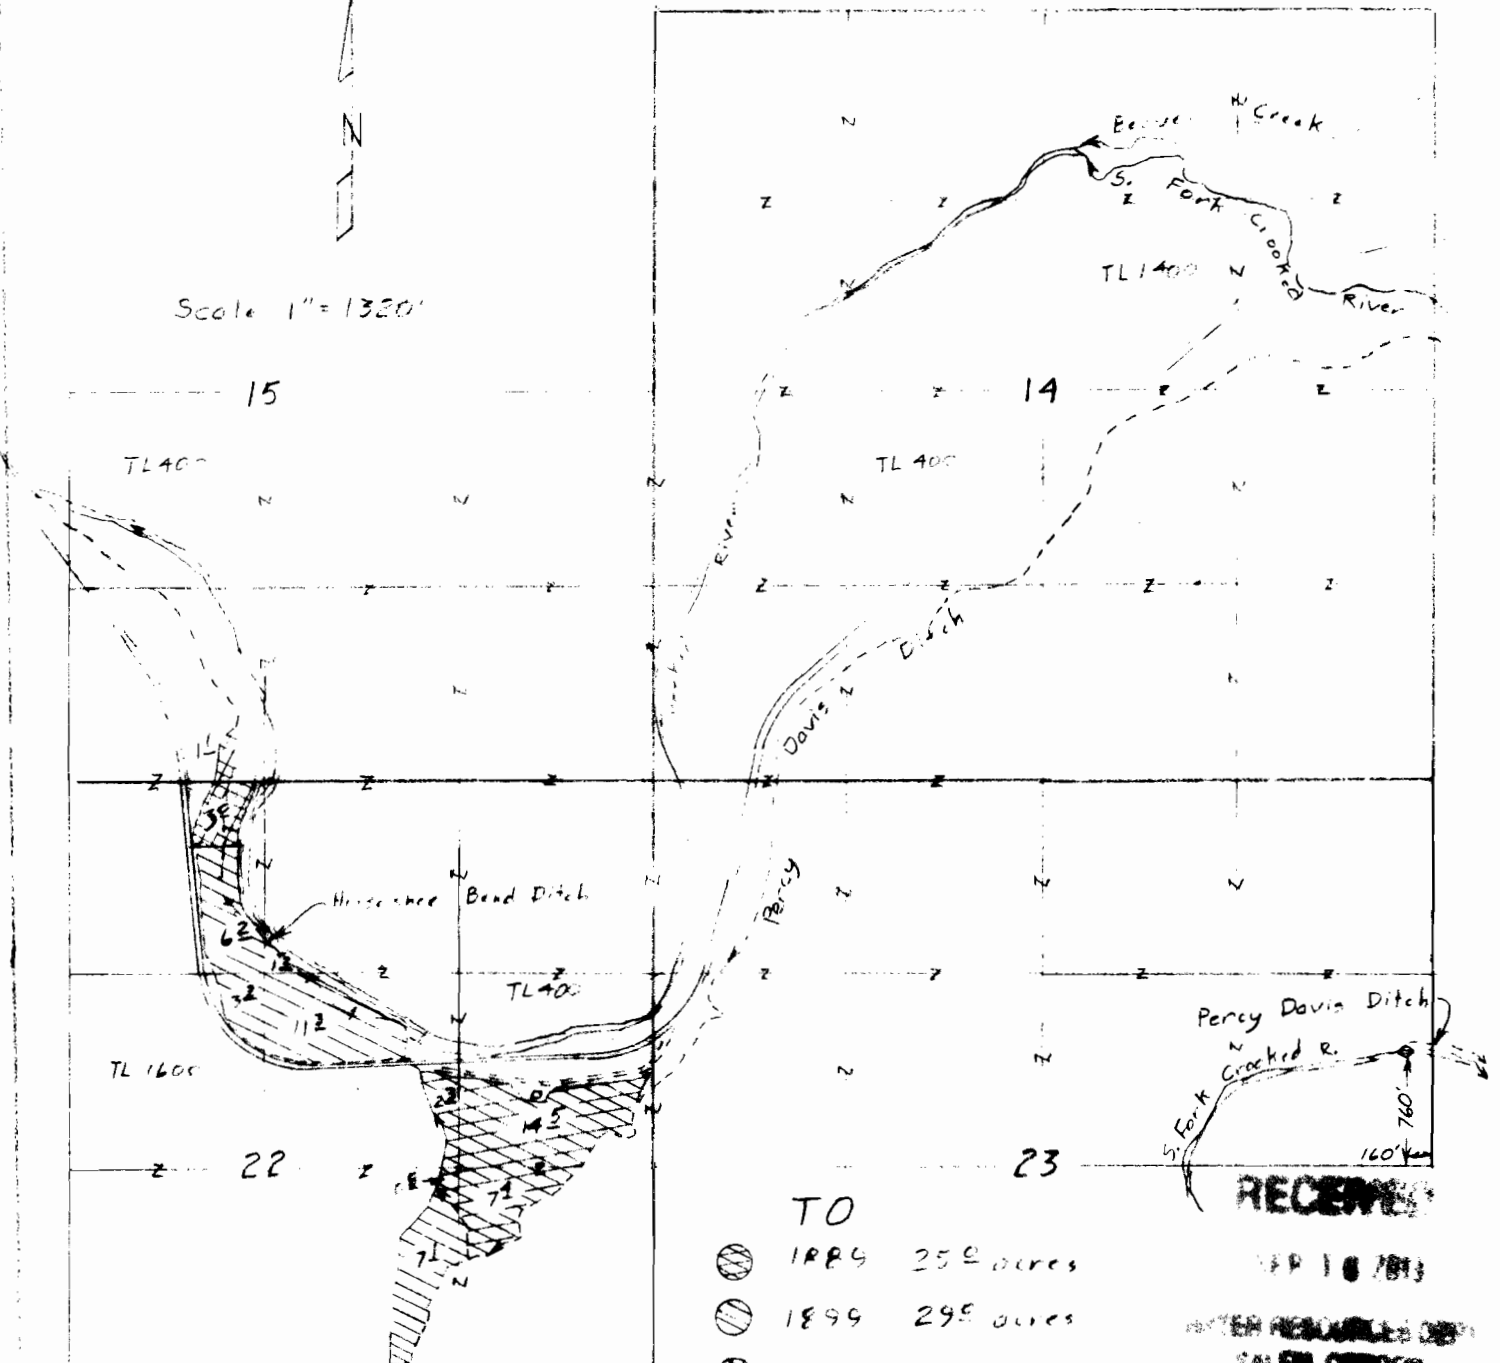

Scale 1" = 1320'



Surveyed July 1, 2002

- TO
-  1884 25.0 acres
 -  1899 29.5 acres
 -  1907 41 acres


RECEIVED

SEP 10 2013

STATE OF OREGON
Salem Oregon

Claim of Beneficial Use Not
for
TWIN BUTTES RANCH

T-8544

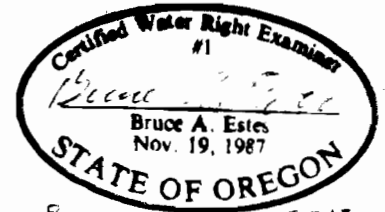

Renewal Dec 31 2013

This map is for the purpose of locating a water right only and has no intent to provide legal dimensions or the location of property lines.

ESTES SURVEYS, LLC

PO Box 17540
Salem, OR 97305-7540
(503) 585-7595

60382 Arnold Rd
Bend, OR 97702
(541) 382-7391