

GROUND WATER APPLICATION MAP

LOCATED IN THE NORTH 1/2 OF THE EAST 1/2 OF THE WEST 1/2 OF
THE NORTHWEST 1/4 OF SECTION 8, TOWNSHIP 1 SOUTH, RANGE 4
EAST, WILLAMETTE MERIDIAN, CONTAINING 20 ACRES MORE OR LESS.

SCALE: 1" = 400' JULY 11, 1996


PERMIT NUMBER G-11650

CLIENT: KEN KERSLAKE
1605 SE 302ND
TROUTDALE, OREGON 97060
(503) 667-5136

RECEIVED

JUL 29 1996

WATER RESOURCES DEPT.
SALEM, OREGON

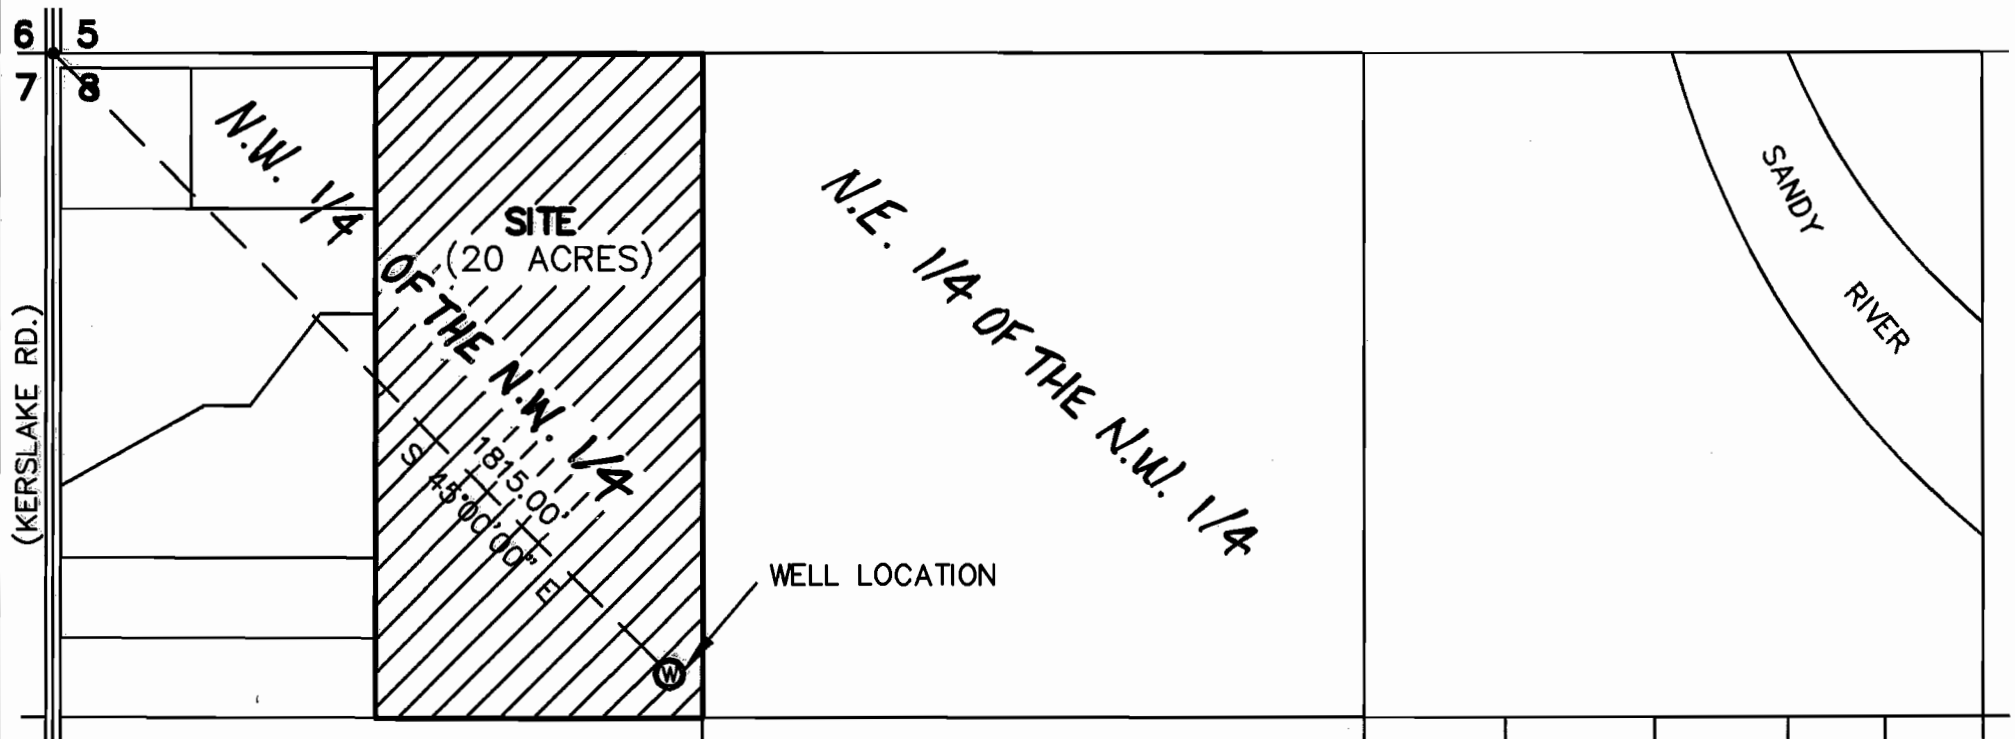

THIS DRAWING IS NOT A LAND SURVEY. PROPERTY LINES
AND/OR OTHER LINES OF OCCUPATION SHOWN HEREON ARE
NOT REPRESENTED BY THE UNDERSIGNED TO MEET
ACCURACY STANDARDS OF LAND SURVEYS.



All COUNTY SURVEYORS
& PLANNERS, INC.
P.O. BOX 955
SANDY, OREGON 97055
(503) 668-3151

JOB# 91-042WR