

CLAIM OF BENEFICIAL USE MAP

TRANSFER T-11011
DOMESTIC USE
FOR

CLIFTON AND DEBRA GEDDIS
17031 MONTEREY ROAD
LAKE ELSINORE, CALIFORNIA 92530
SITUATED IN
SECTION 11, TOWNSHIP 34 SOUTH, RANGE 1 EAST, W.M.
JACKSON COUNTY, OREGON

LEGEND

- POINT OF DIVERSION (SPRING POD)
- - - 1/4-1/4 SECTION LINE
- - - PIPELINE




This map is not intended to provide legal dimensions or locations of property ownership lines.

EHM-September 18, 2013

RENEWES: 12/31/2014

COBU MAP #783

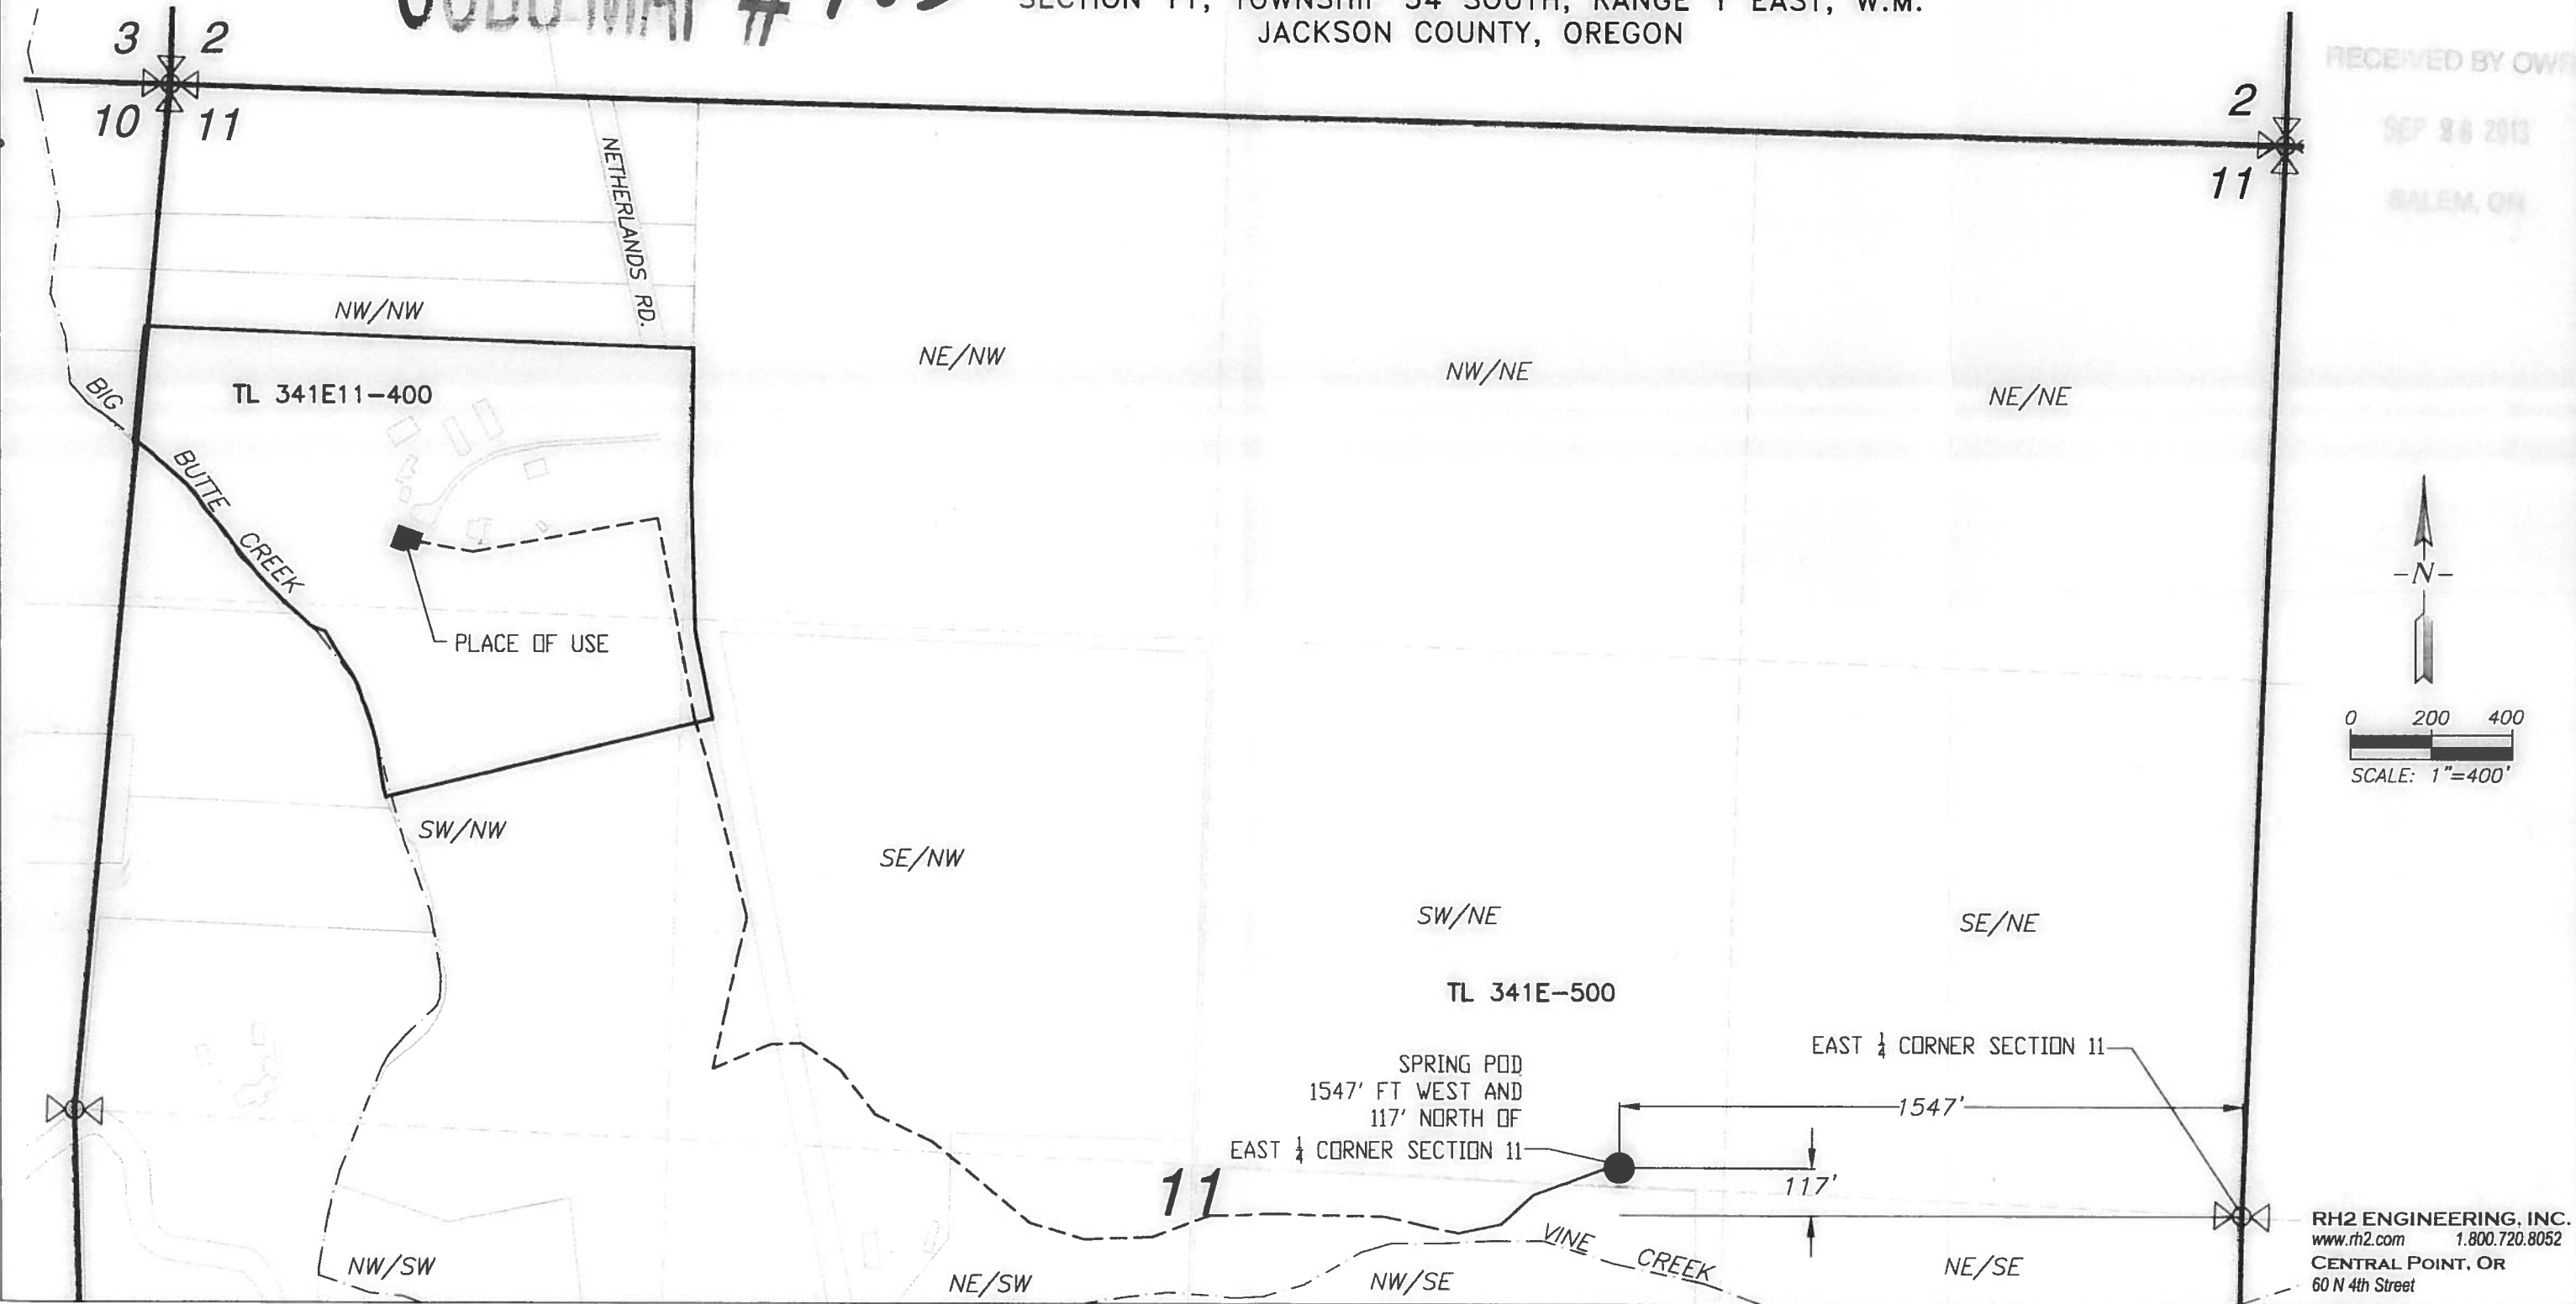

RH2 ENGINEERING, INC.
www.rh2.com 1.800.720.8052
CENTRAL POINT, OR
60 N 4th Street