



FINAL PROOF SURVEY
 CLAIM OF BENEFICIAL USE
 SEC 32, 33, AND 34, T28S, R6W, W. M.
 SEC 3 AND 4, T29S, R6W, W. M.
 WATER RIGHTS TRANSFER T-6709
 FOR ROSEBURG FOREST PRODUCTS

PLACE OF USE 



SEPTEMBER 20, 2001

SCALE: 1" = 1320'

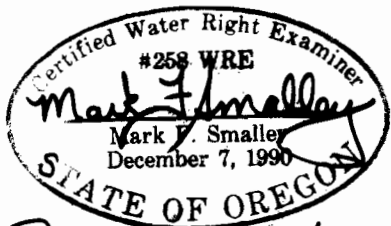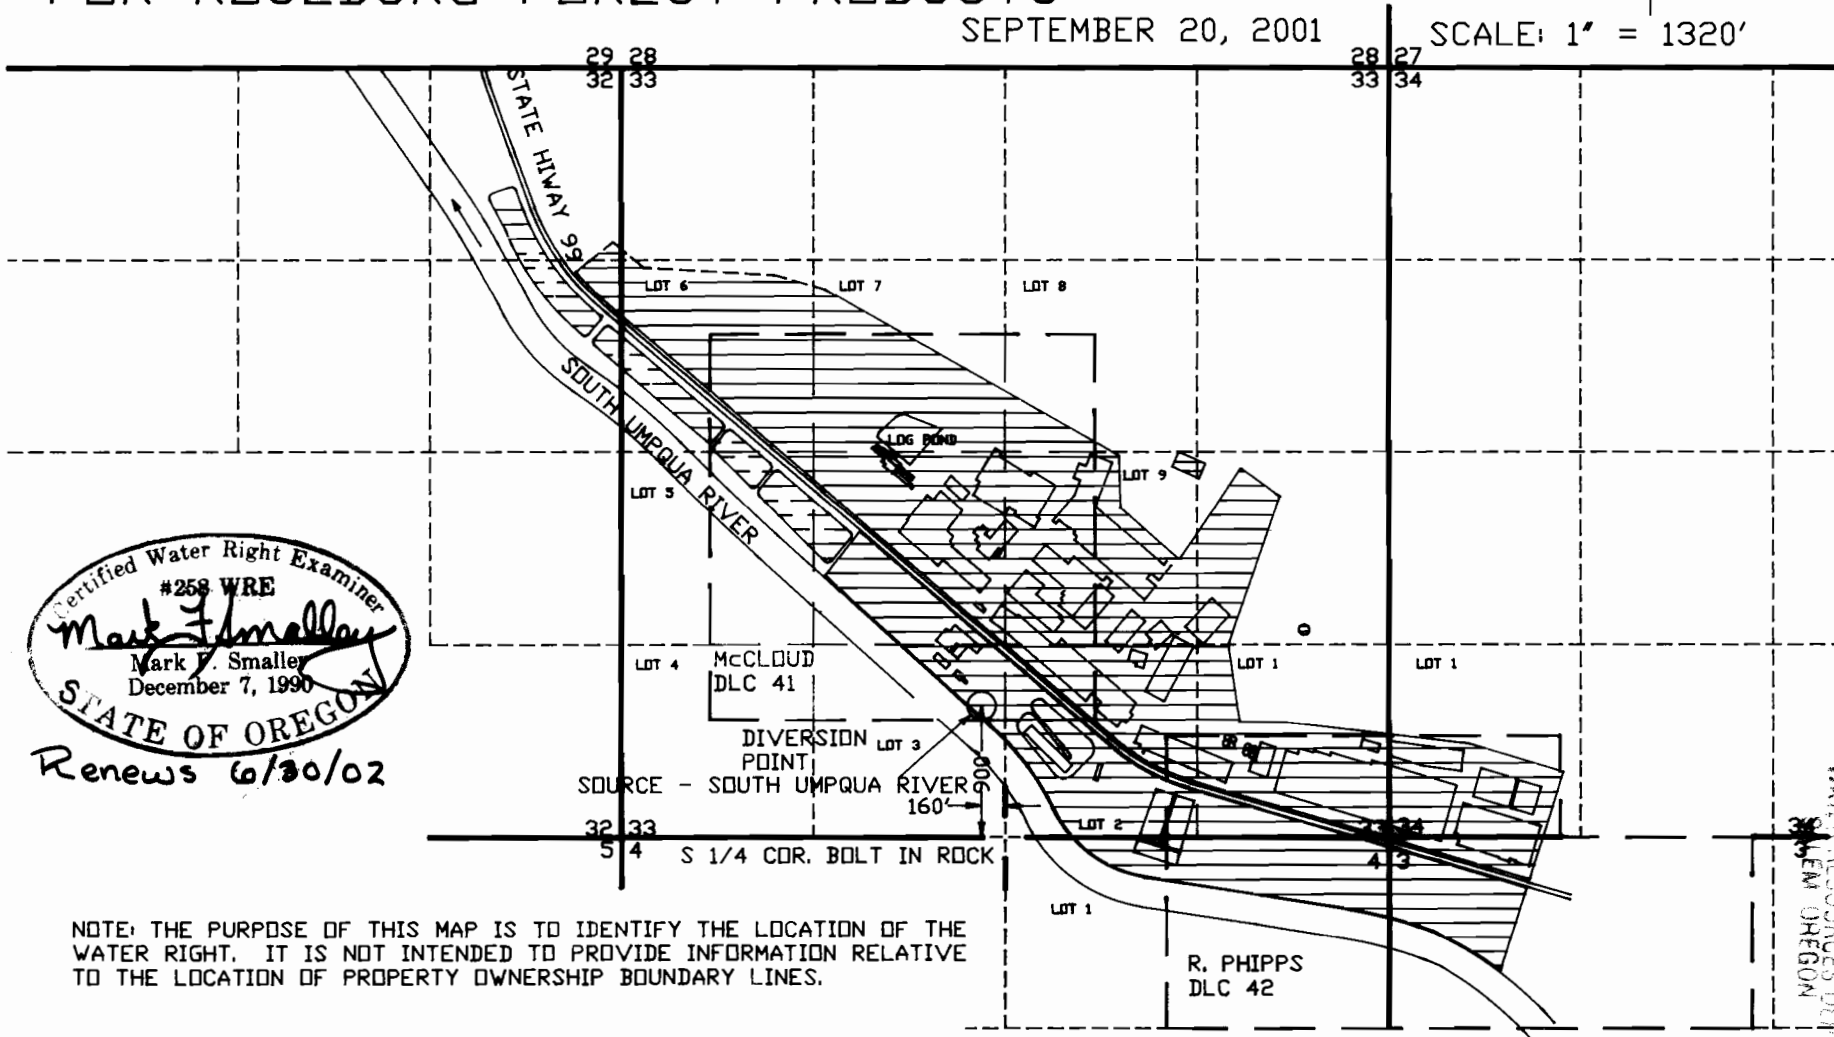

Renews 6/30/02

NOTE: THE PURPOSE OF THIS MAP IS TO IDENTIFY THE LOCATION OF THE WATER RIGHT. IT IS NOT INTENDED TO PROVIDE INFORMATION RELATIVE TO THE LOCATION OF PROPERTY OWNERSHIP BOUNDARY LINES.

WATER RESOURCES DEPT

SEP 26 2001

RECEIVED