28815

50672

T. 13S. R. 30E. W. M.

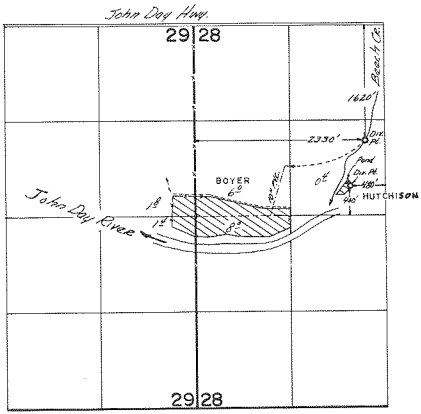

FINAL PROOF SURVEY

UNDER

Application No. 38677 Permit No. 28815

IN NAME OF

Donald & Elsa Boyer

Robert & Wilda Hutchison

Surveyed Sept. 13, 1979, by S.C. BROWN

PTS-1979-A LRD.