

T 11S, R 10 R., W.M SECTIONS 20 & 21

Tax Lot 500


LINCOLN COUNTY, OREGON

RECEIVED

DEC 20 2010


WATER RESOURCES DEPT
SALEM, OREGON

Scale: 1 inch = 400 feet

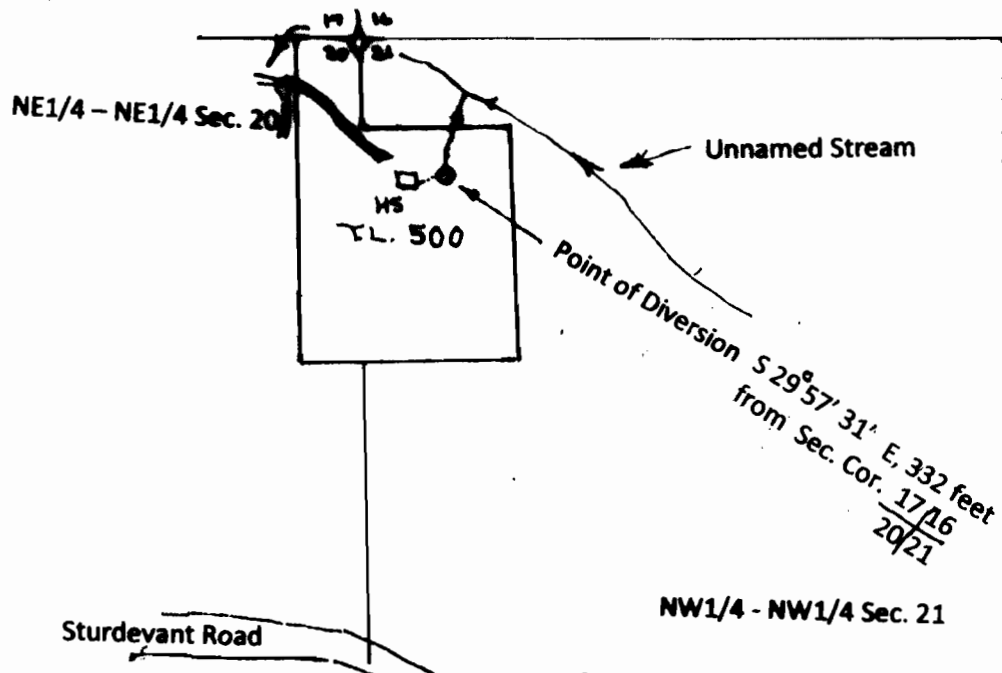

Legend

- Point of Division
- Section Lines
- - 1/16 Section Line
- Tax Lot Boundaries
- ... Pipe line

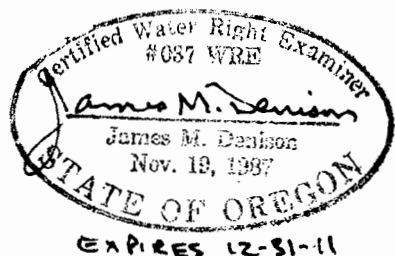

FINAL PROOF SURVEY
UNDER
APPLICATION# s73014 PERMIT#52063

IN THE NAME OF
JIM & NINA HAMMOND

SURVEYED: November 12, 1992

BY: JAMES M. DENISON

THIS MAP PREPARED SOLEY FOR THE PURPOSE OF SHOWING LOCATION OF A WATER RIGHT, AND IS NOT INTENDED FOR USE TO PROVIDE DIMENSIONS OR LOCATION OR PROPERTY OWNERSHIP LINES.