


TOWNSHIP 15 S, RANGE 16 E, W. M.

North

Found

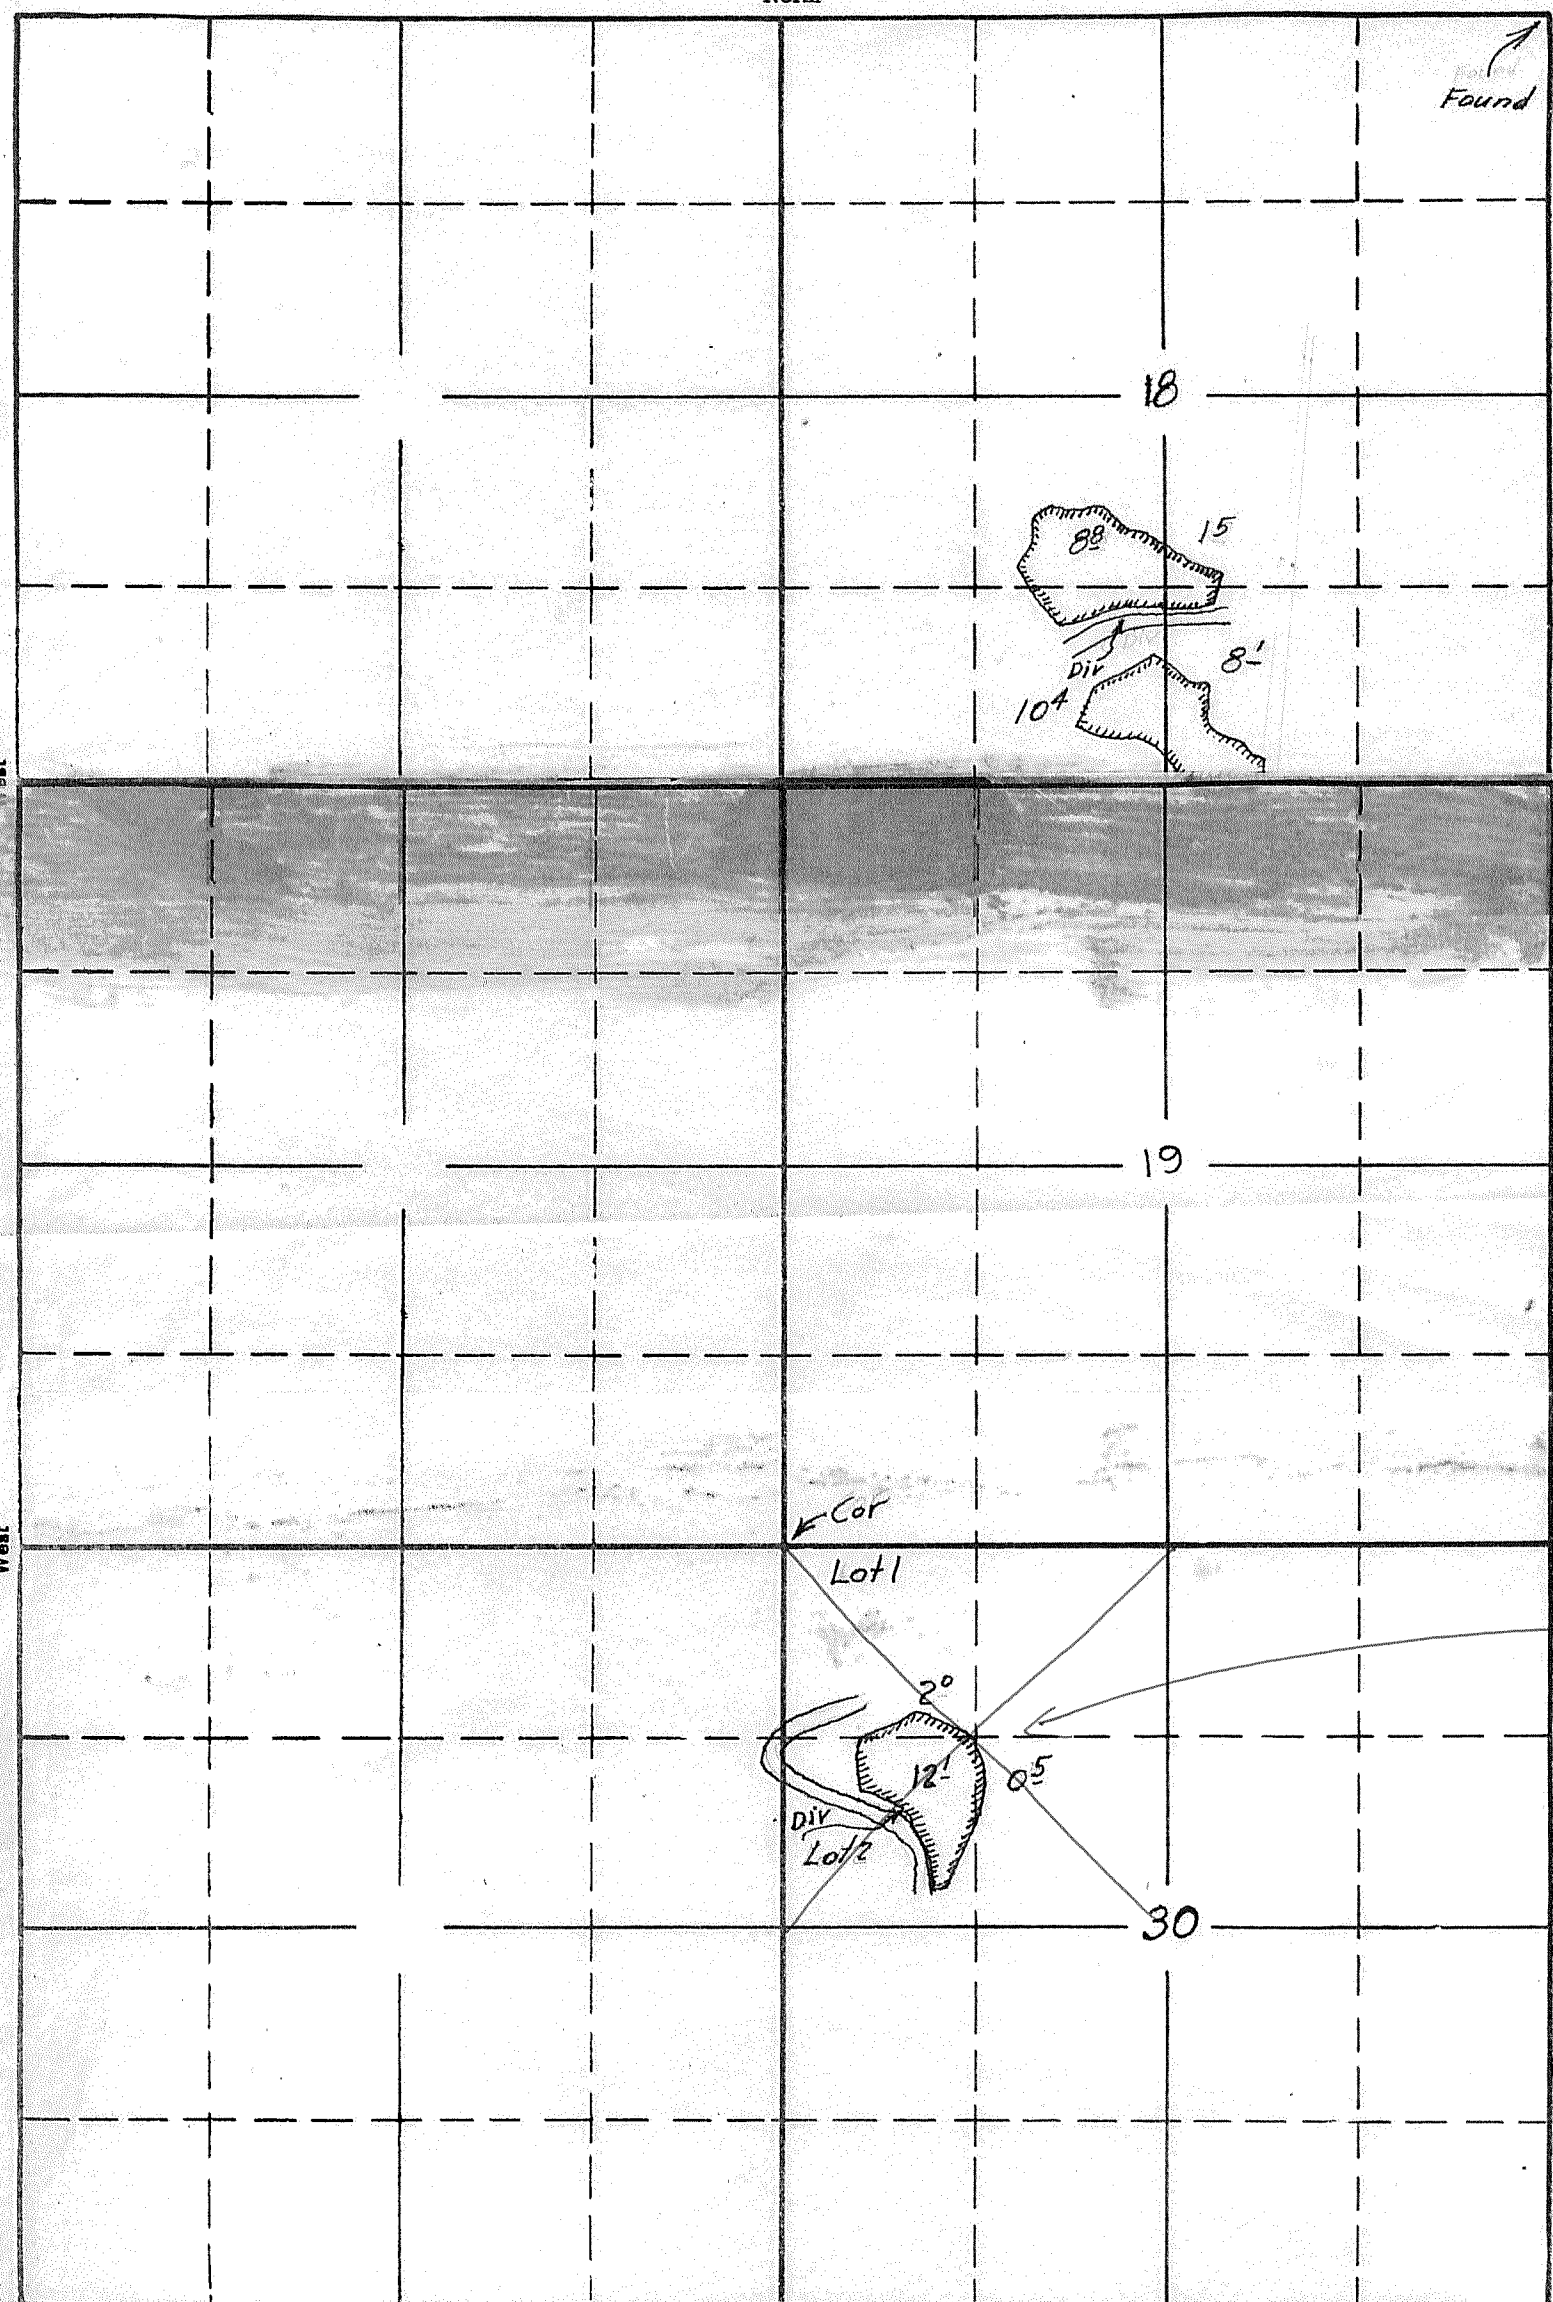

Cancelled
Sp OR Vol 38
Page 439

South

APPLICATION No. 15876
PERMIT No. 11726

1939 PTS
5-10-39