


# T.6S.R.2W.W.M.

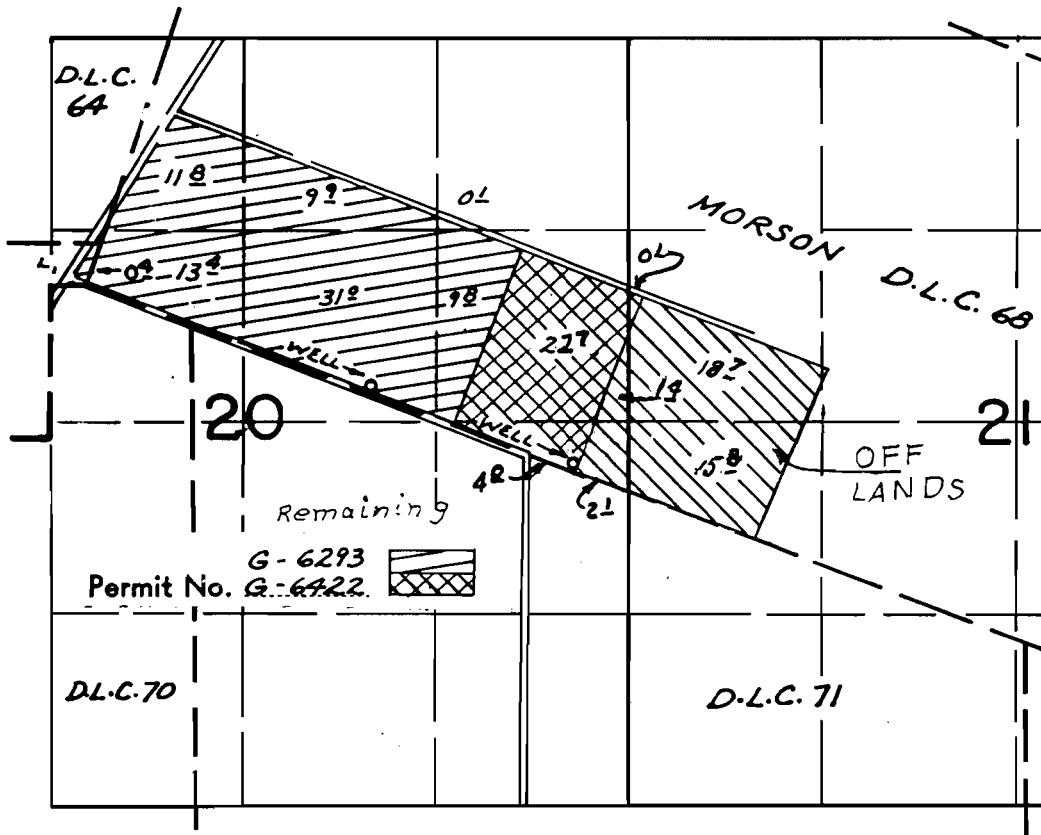

WELLS LOC: 700'S. & 1930'E ; 1230'S. & 3330'E, BOTH FROM S.W. COR. D.L.C. 68

## WATER RIGHT MAP FOR

ROBERT & PAMELA ZIELINSKI

T 7087

THIS MAP WAS PREPARED FOR THE PURPOSE OF IDENTIFYING THE LOCATION OF A WATER RIGHT ONLY AND IS NOT INTENDED TO PROVIDE LEGAL DIMENSIONS OR LOCATION OF PROPERTY OWNERSHIP LINES.

