



CLAIM OF BENEFICIAL USE
 WATER RIGHT TRANSFER
 IN THE NAME OF: MT. HOOD COMMUNITY COLLEGE
 WATER RIGHT TRANSFER APPLICATION # T-8582
 IN SECTION 2, T.1 S., R.3 E., W.M.

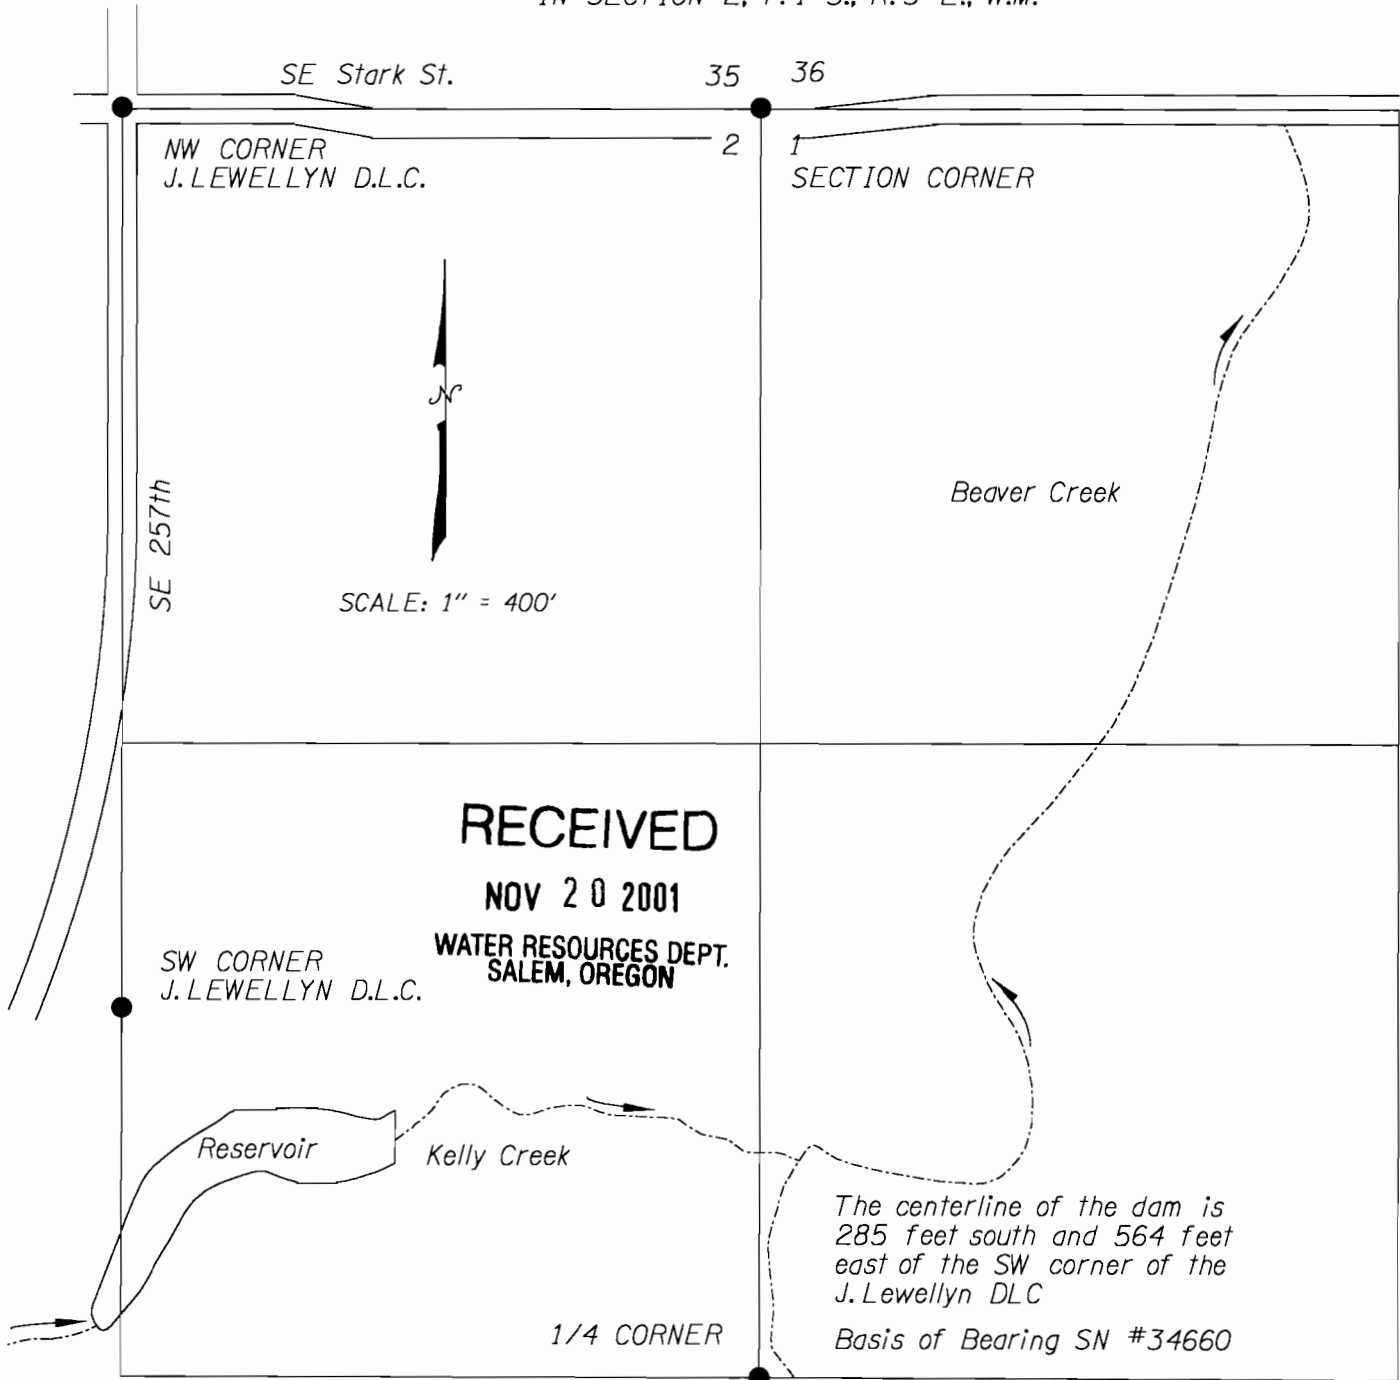

The purpose of this map is to identify the location of the water right. It is not intended to provide information relative to the location of property ownership or boundary lines.



18438 S.E. PINE STREET
 PORTLAND, OREGON 97233 618-0564

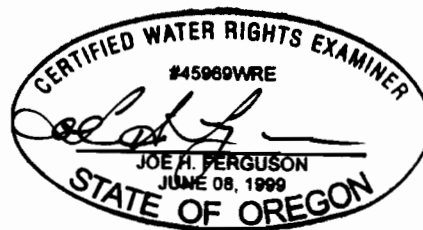

Surveyed November 6, 2001 By Joe H Ferguson