



MAP TO ACCOMPANY CLAIM OF BENEFICIAL USE FOR TRANSFER T-8487

LOCATED IN SECTION 20 AND 30
TOWNSHIP 25 SOUTH, RANGE 19 EAST, W.M.
AND IN SECTION 6
TOWNSHIP 26 SOUTH, RANGE 19 EAST, W.M.
LAKE COUNTY, OREGON

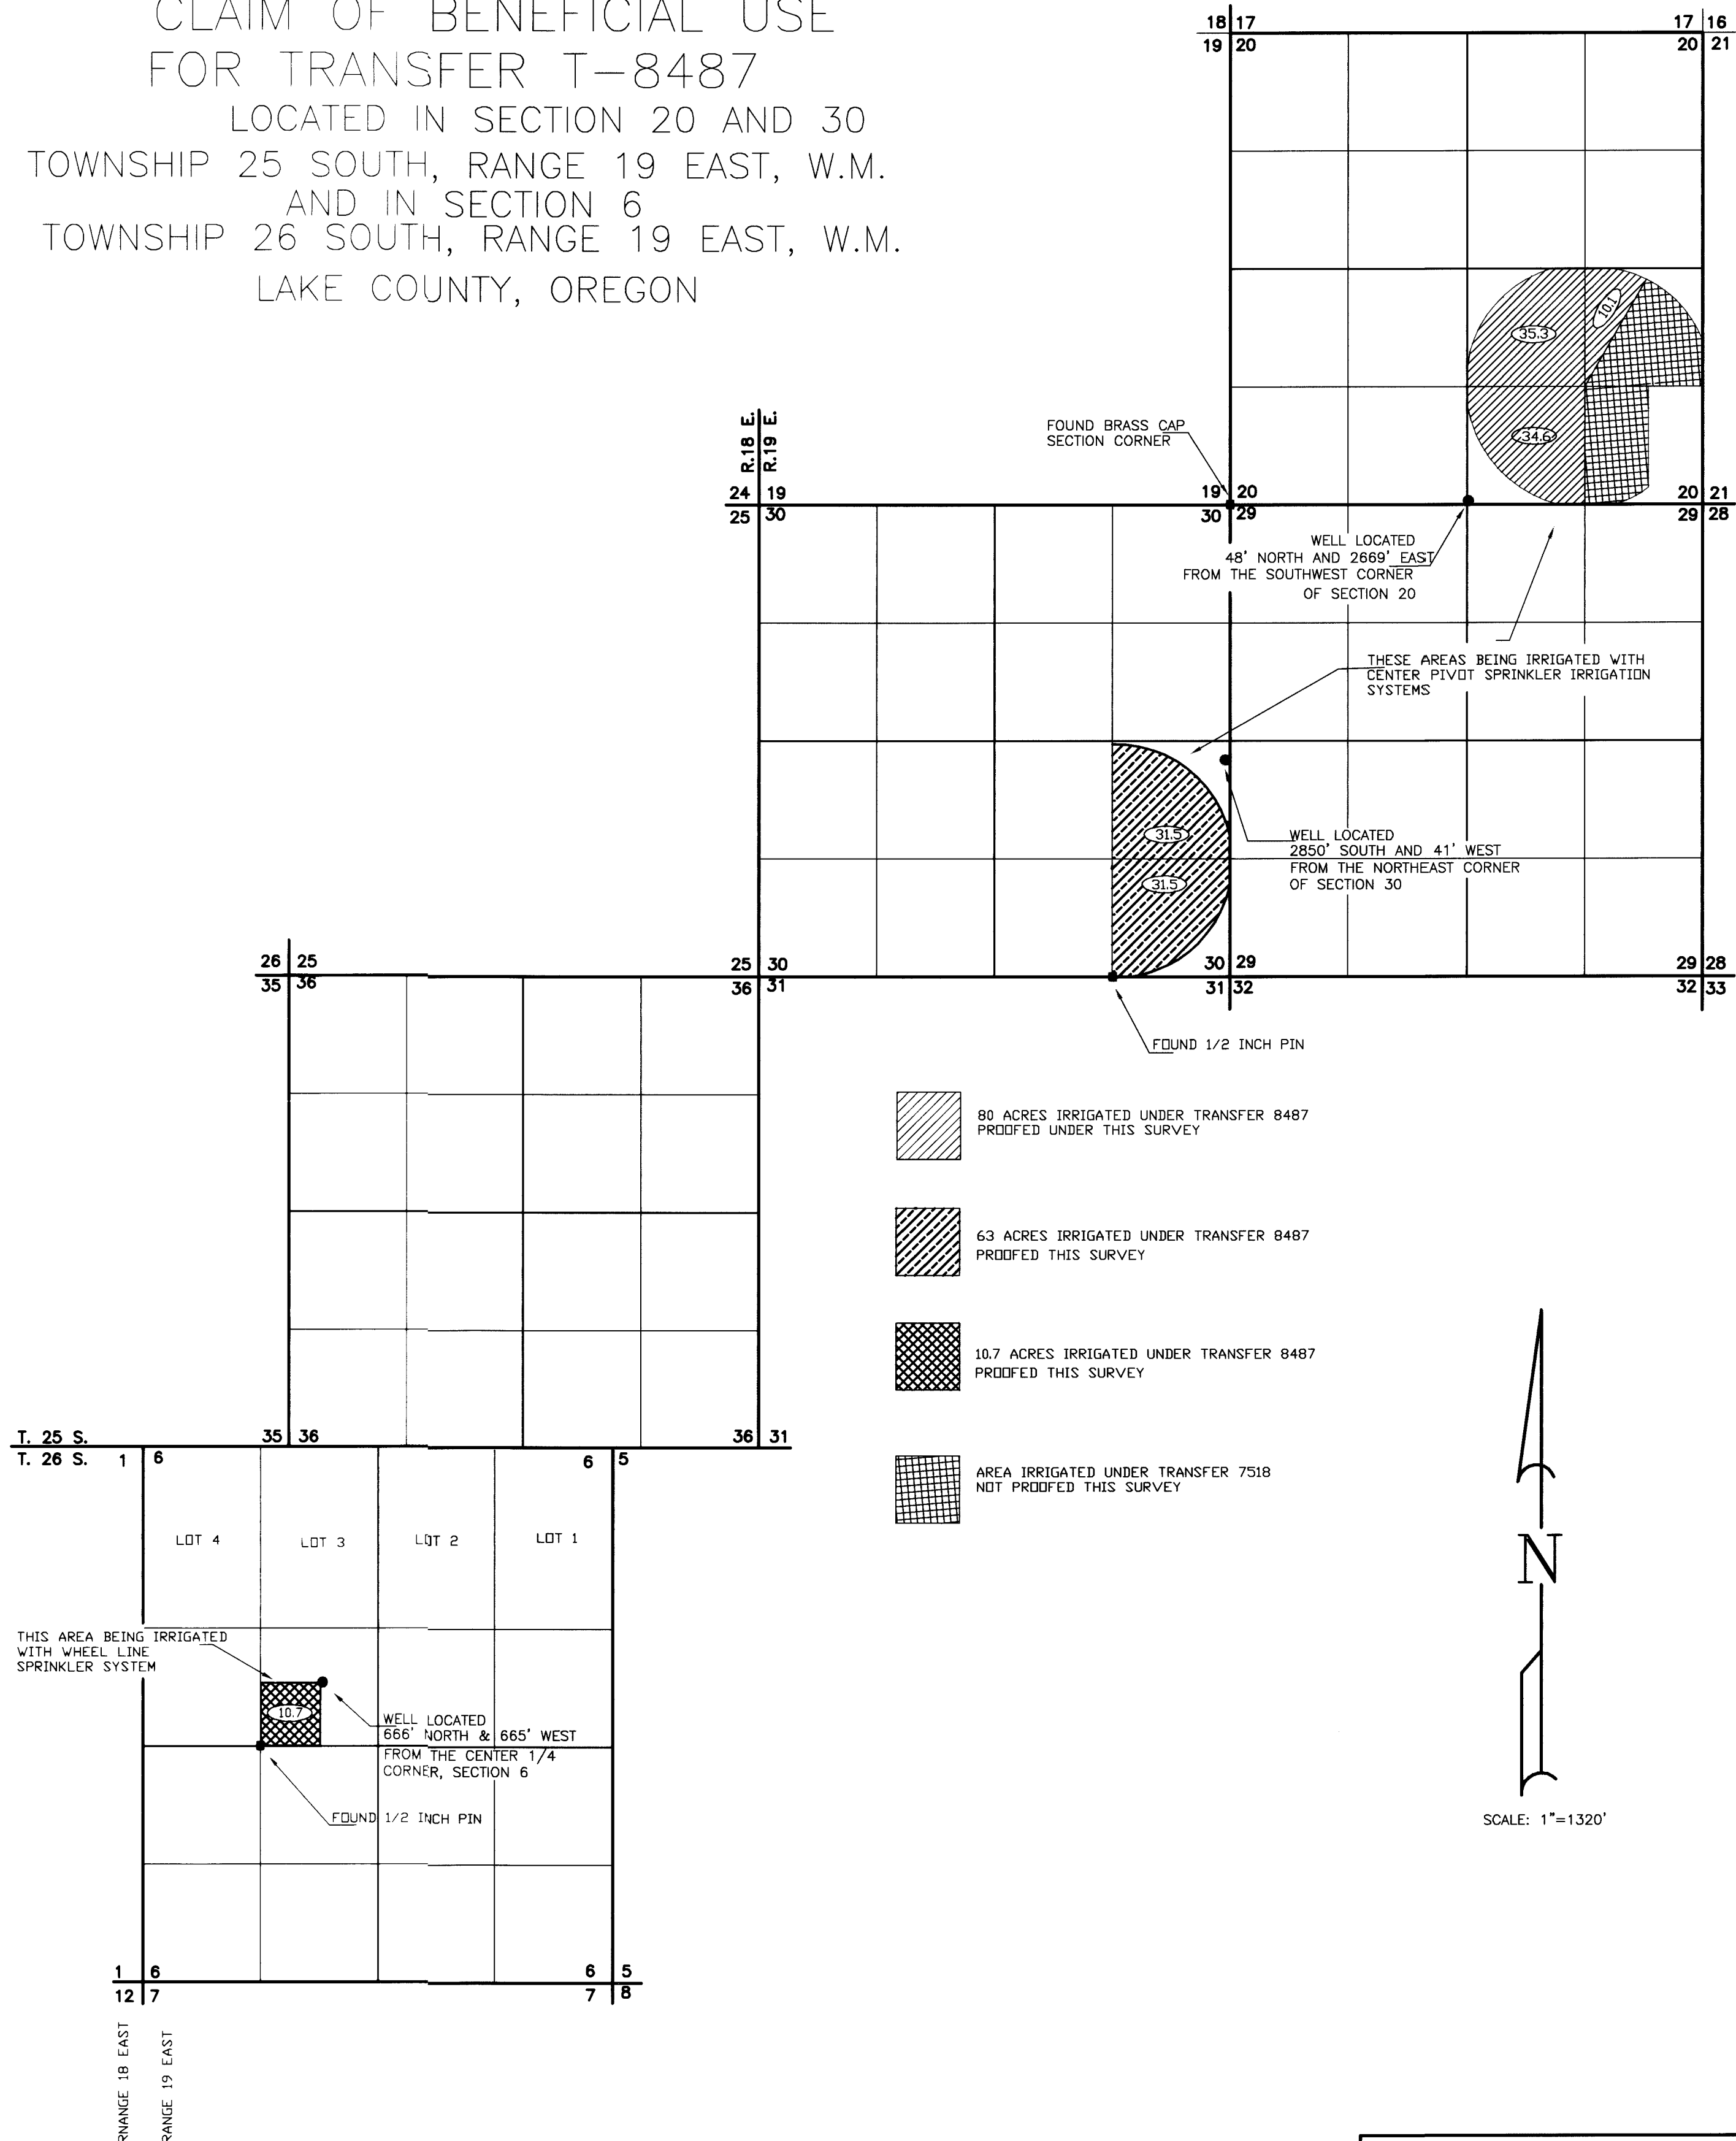

NOTE: PREPARATION OF THIS MAP IS FOR IDENTIFYING PROPOSED
WATER RIGHTS ONLY. IT HAS NO INTENT TO PROVIDE LOCATIONS
OR DIMENSIONS OF PROPERTY BOUNDARIES.

COBU MAP # 0110

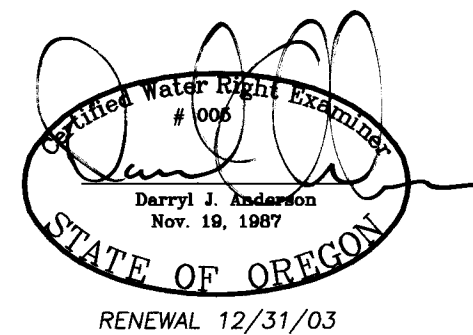

PREPARED FOR:
GARY L. AND LINDA S. PERKINS
PO BOX 118
CHRISTMAS VALLEY, OR 97641

PREPARED BY:
ANDERSON ENGINEERING & SURVEYING, INC.
P.O. BOX 28 P.O. BOX 419
LAKEVIEW, OREGON 97630 REDMOND, OREGON 97756
(541) 947-4407 (541) 923-4307
FAX 947-2321 FAX 923-4308

DATE: 10/10/03 DWG. FILE: 2003-62
JOB NO.: 2003-62 SHEET 1 OF 1