FINAL PROOF MAP

FOR

T-6588 FORMERLY CERT'S 2618, 2619 & 2934
WARREN TAYLOR

T2N, R31E. WM

RECEIVED
JAN 12 2007
WATER RESOURCES DEPT
SALEM, OREGON

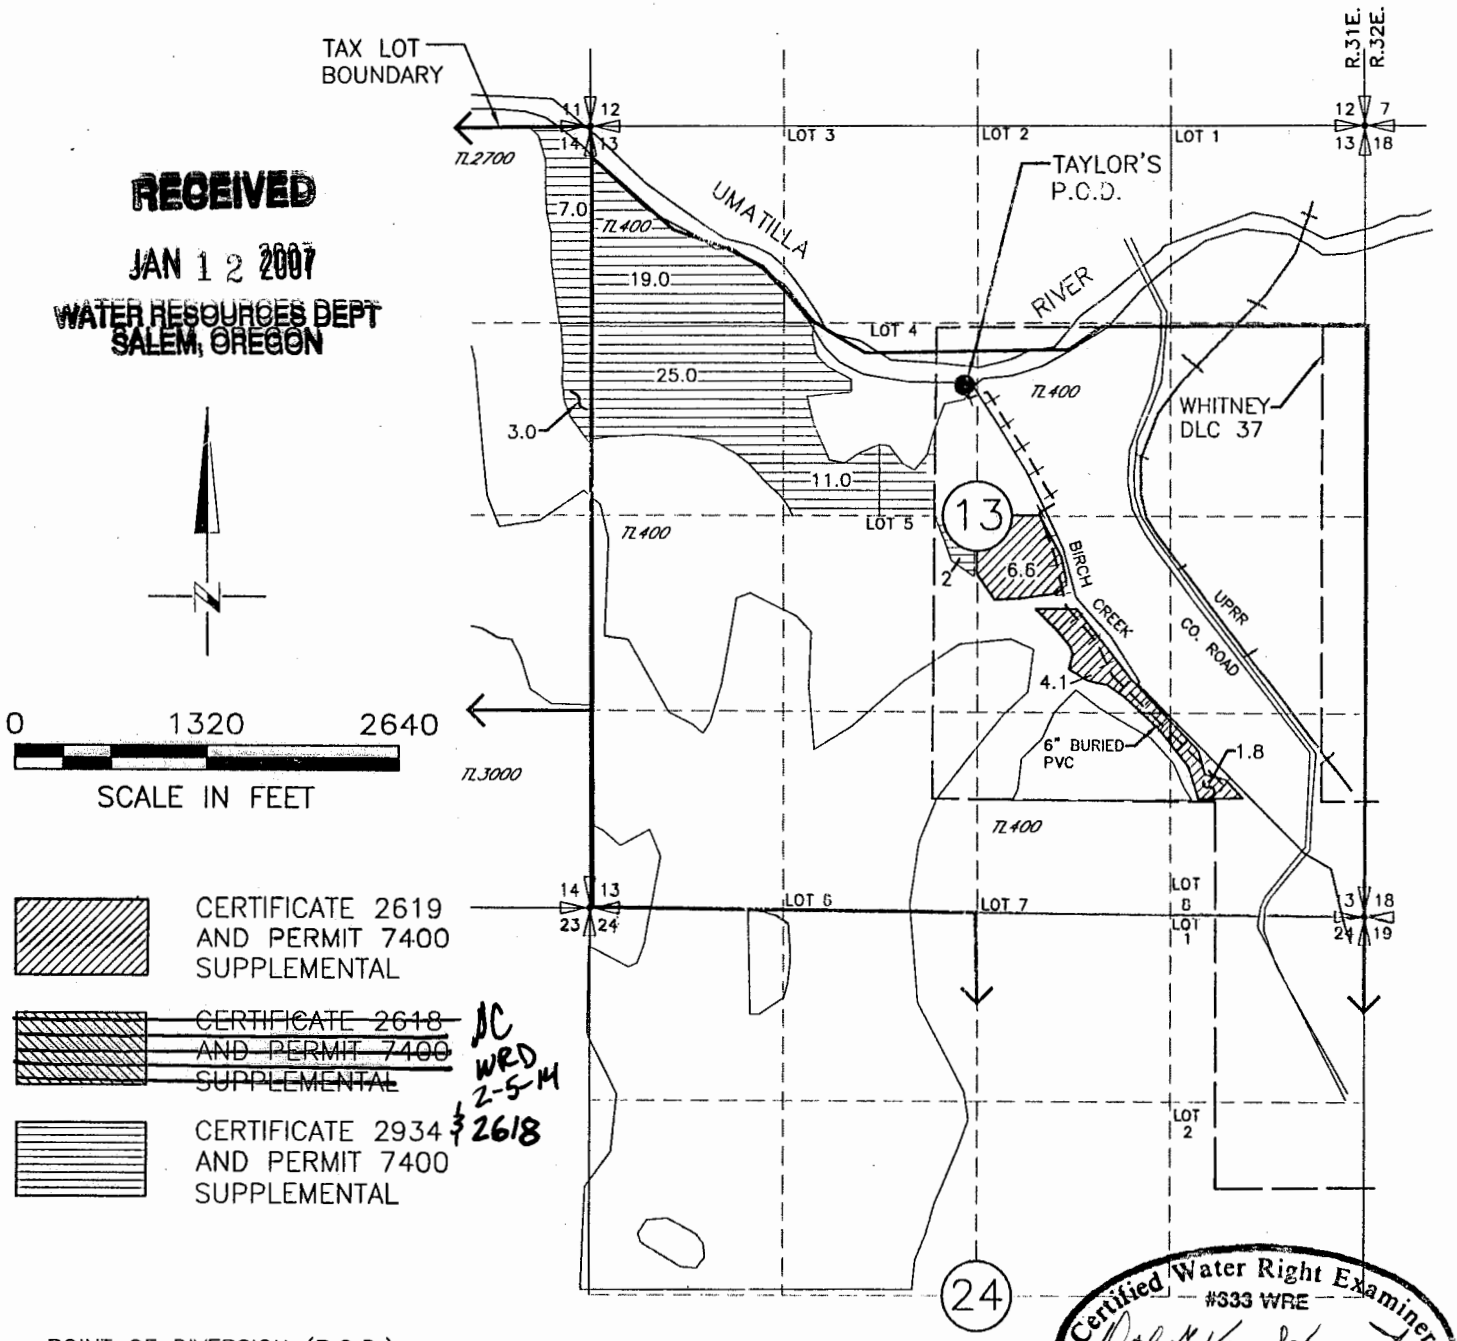

JC
WRD
2-5-14

POINT OF DIVERSION (P.O.D.)
AT THE CONFLUENCE OF THE UMATILLA RIVER AND BIRCH CREEK: 1750' S AND 2730' W FROM N.E. CORNER OF SECTION 13

FISH SCREENS AND FLOW METER ARE LOCATED AT TAYLOR'S P.O.D.

Certified Water Right Examiner
#333 WRE
Dale G. VanSchenck
May 19, 1992
12/12/06
STATE OF OREGON

DRAWING: H:\CAD\AG\3522\308\3522308\3522080BFP.DWG
PRINTED BY: Roger.Willard on 12/12/06 03:30 PM

NOTE: THE PURPOSE OF THIS MAP IS TO IDENTIFY THE APPROXIMATE LOCATION OF THE WATER RIGHT. IT IS NOT INTENDED TO PROVIDE INFORMATION RELATIVE TO THE LOCATION OF PROPERTY OWNERSHIP BOUNDARY LINES.

SCM Consultants, Inc.
A Tetra Tech Company