

Point of Diversion No. 1—Certificate No. 55252 Sturgis Fork in SW1/4NE1/4 Section 19; 1265 feet North and 1380 feet West from East 1/4 Corner Section 19.

Point of Diversion No. 1—Headgate and Inline Flow Meter, UTM—Meter Coordinate Position E 0482182, N 4658431, CONUS—NAD 1927 Zone 10.

Point of Diversion No. 2—Certificate No. 48016 Steve's Fork in NW1/4SW1/4 Section 20; 720 feet South and 665 feet East from the East 1/4 Corner Section 19.

Point of Diversion No. 2—Gate Valve and Inline Flow Meter, UTM—Meter Coordinate Position E 0482878, N 4658005, CONUS—NAD 1927 Zone 10.

CLAIM OF BENEFICIAL USE MAP
TRANSFER — 9924
NE1/4SE1/4, SE1/4SE1/4 AND SW1/4SE1/4, SECTION 21
SW1/4SW1/4, SECTION 22
T.40S., R.4W., W.M.
JACKSON COUNTY, OREGON

FOR
RONALD F. WESSMAN
6026 CARBERRY CREEK ROAD
JACKSONVILLE, OR 97540
SEPTEMBER 25, 2012

RECEIVED BY OWRD



OCT 11 2012

SALEM, OR

* Distance determined by scaling
** Elevation difference determined by GPS
Garmin E-Trex Vista — +/- 10 vertical feet accuracy


MAINLINE PIPE TABLE

Point	Distance*	Elevation**
△ = P.O.D. No. 1		2535
10" PVC	3200±	2500
10" PVC	8800±	2410
6" PVC	1200±	2415
5" PVC	1000±	2415
4" PVC	2800±	2035
△ = P.O.D. No. 2		2480
6" PVC	700±	2500

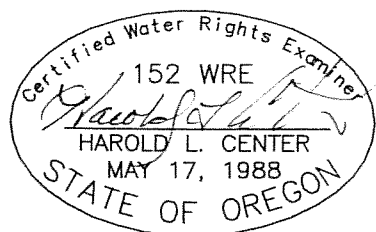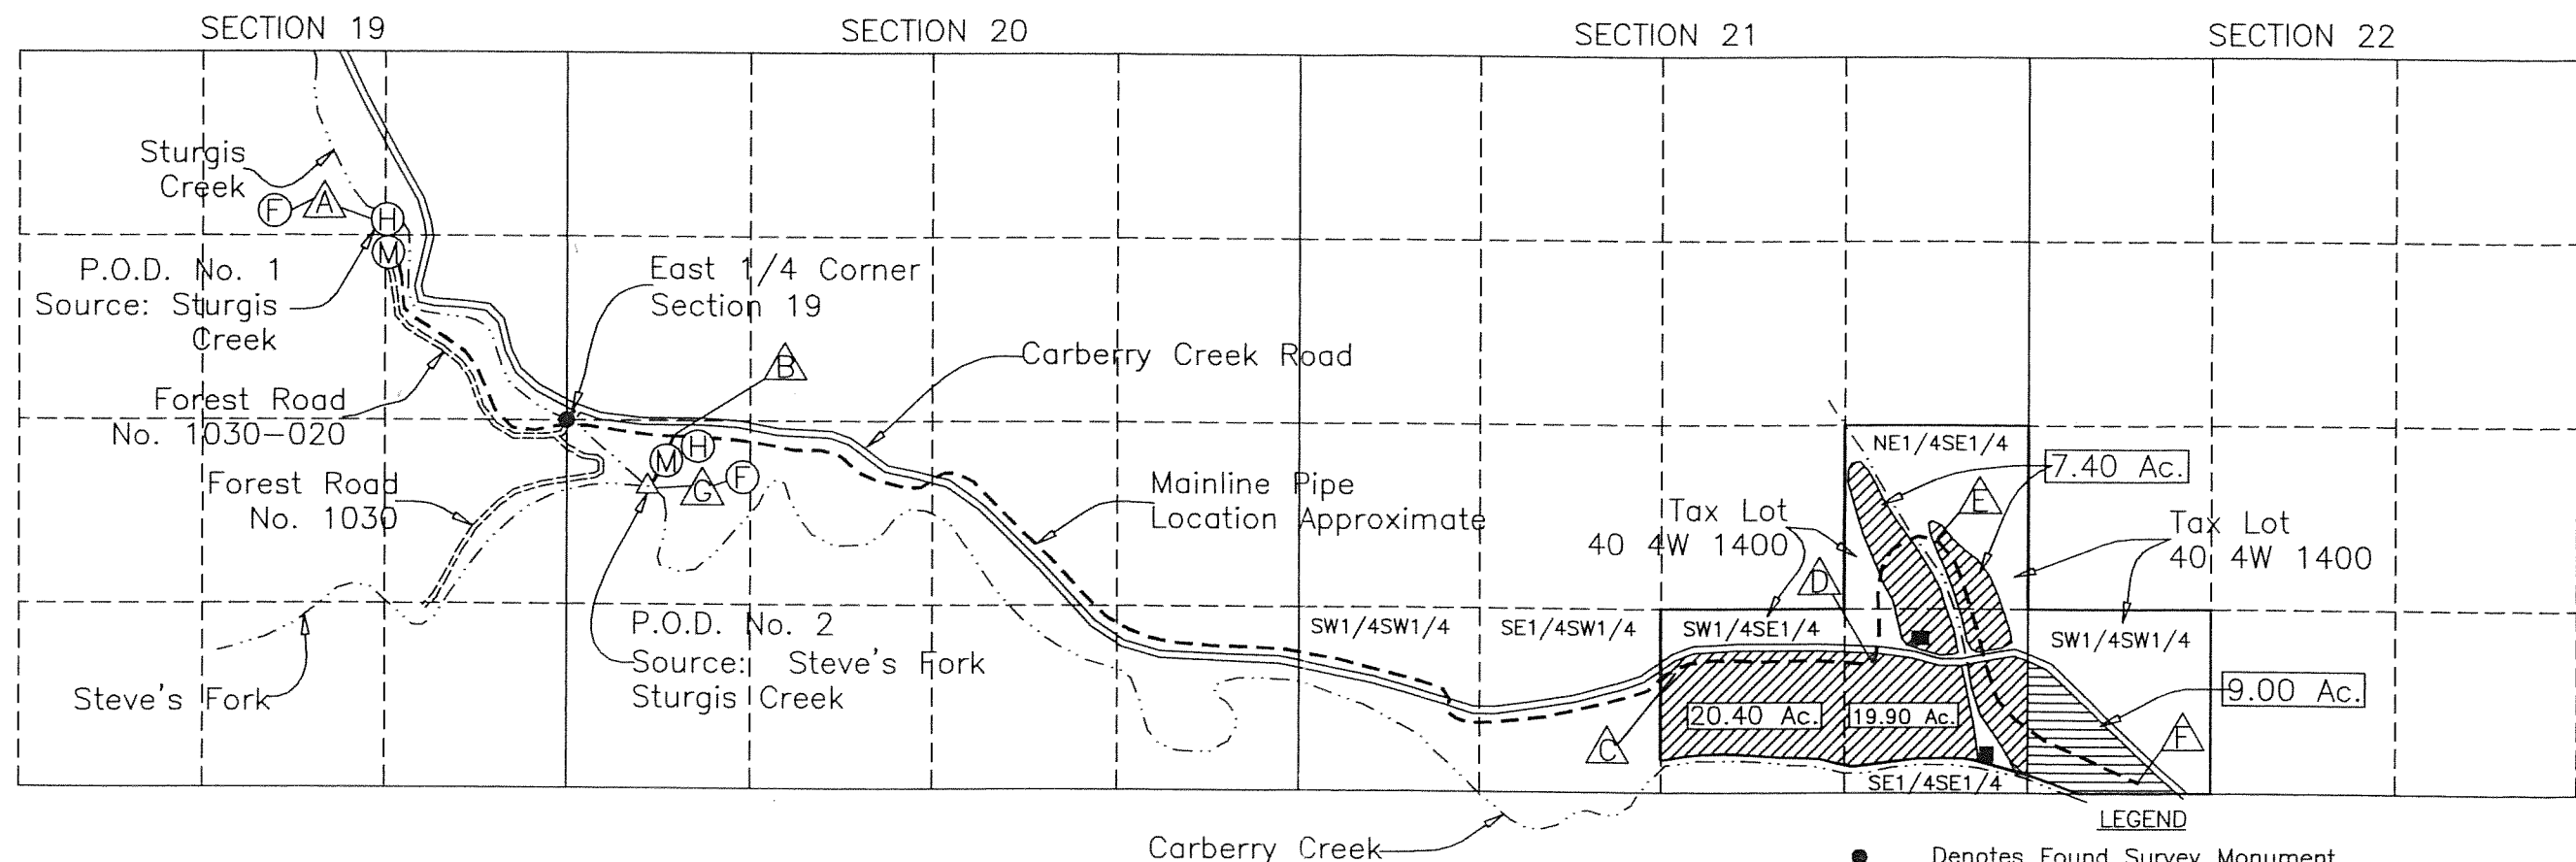

SURVEYOR

HAROLD L. CENTER
2604 David Lane
Medford, OR 97504
Phone 541-535-6108
Oregon Certificate No. 1071
Certificate Renewal Date: 12/31/13

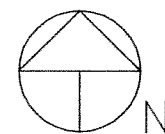

0 660 1320 1980 2640
Scale 1" = 1320'

This map was prepared for the purpose of identifying the location of a water right only and is not intended to provide legal dimensions or location of property ownership.

- LEGEND
- Denotes Found Survey Monument
 - Denotes Building or Structure
 - Denotes Carberry Creek Road—County Road
 - Denotes Forest Service Road
 - - - - Denotes Mainline Pipe—Location Approximate
 - ⊙ Denotes Fish Screen at Points A and G
 - Ⓜ Denotes Flow Meter
 - Ⓜ Denotes Headgate
 - ▨ Denotes Area Authorized Place of Use, Primary Priority Date 1857, Supplemental Date January 11, 1957.
 - ▨ Denotes Area Authorized Place of Use, Primary Priority Date May 4, 1970.

COBU MAP # 721 *folded*