


# T.6 S.R.IE.W.M.

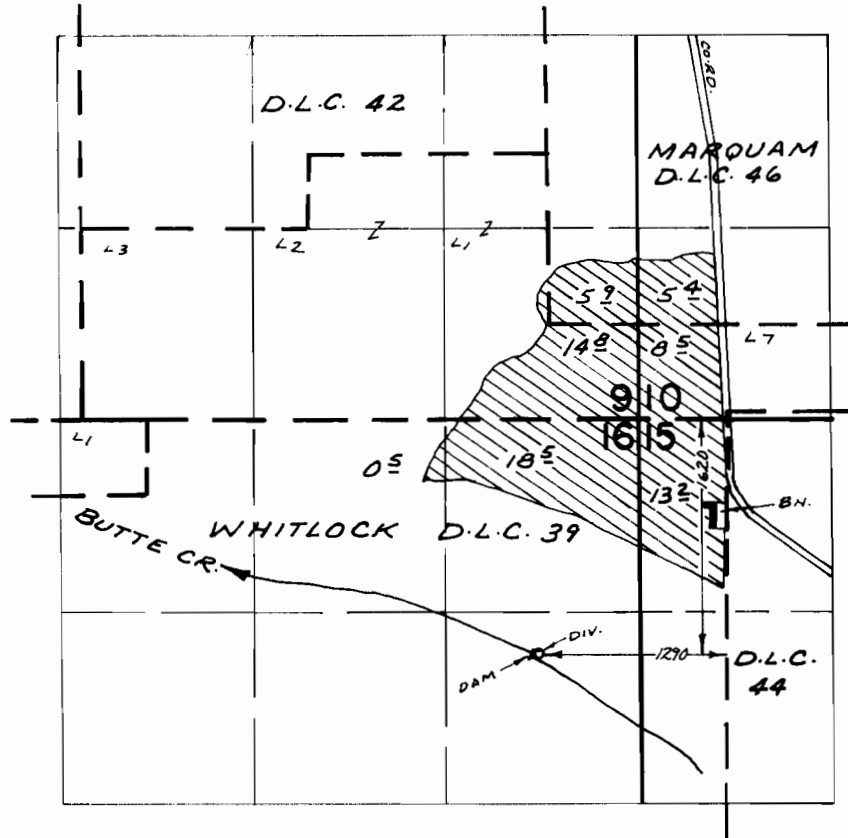

## FINAL PROOF SURVEY UNDER

Application No. 38759 Permit No. 28844  
IN NAME OF

FRED KASER

Surveyed JULY 2, 1973, by R. MUCKEN