


Claim of Beneficial Use Map

Permit R-6171, Application R-52124

Township 10 & 11 South, Range 11 West (W.M.)

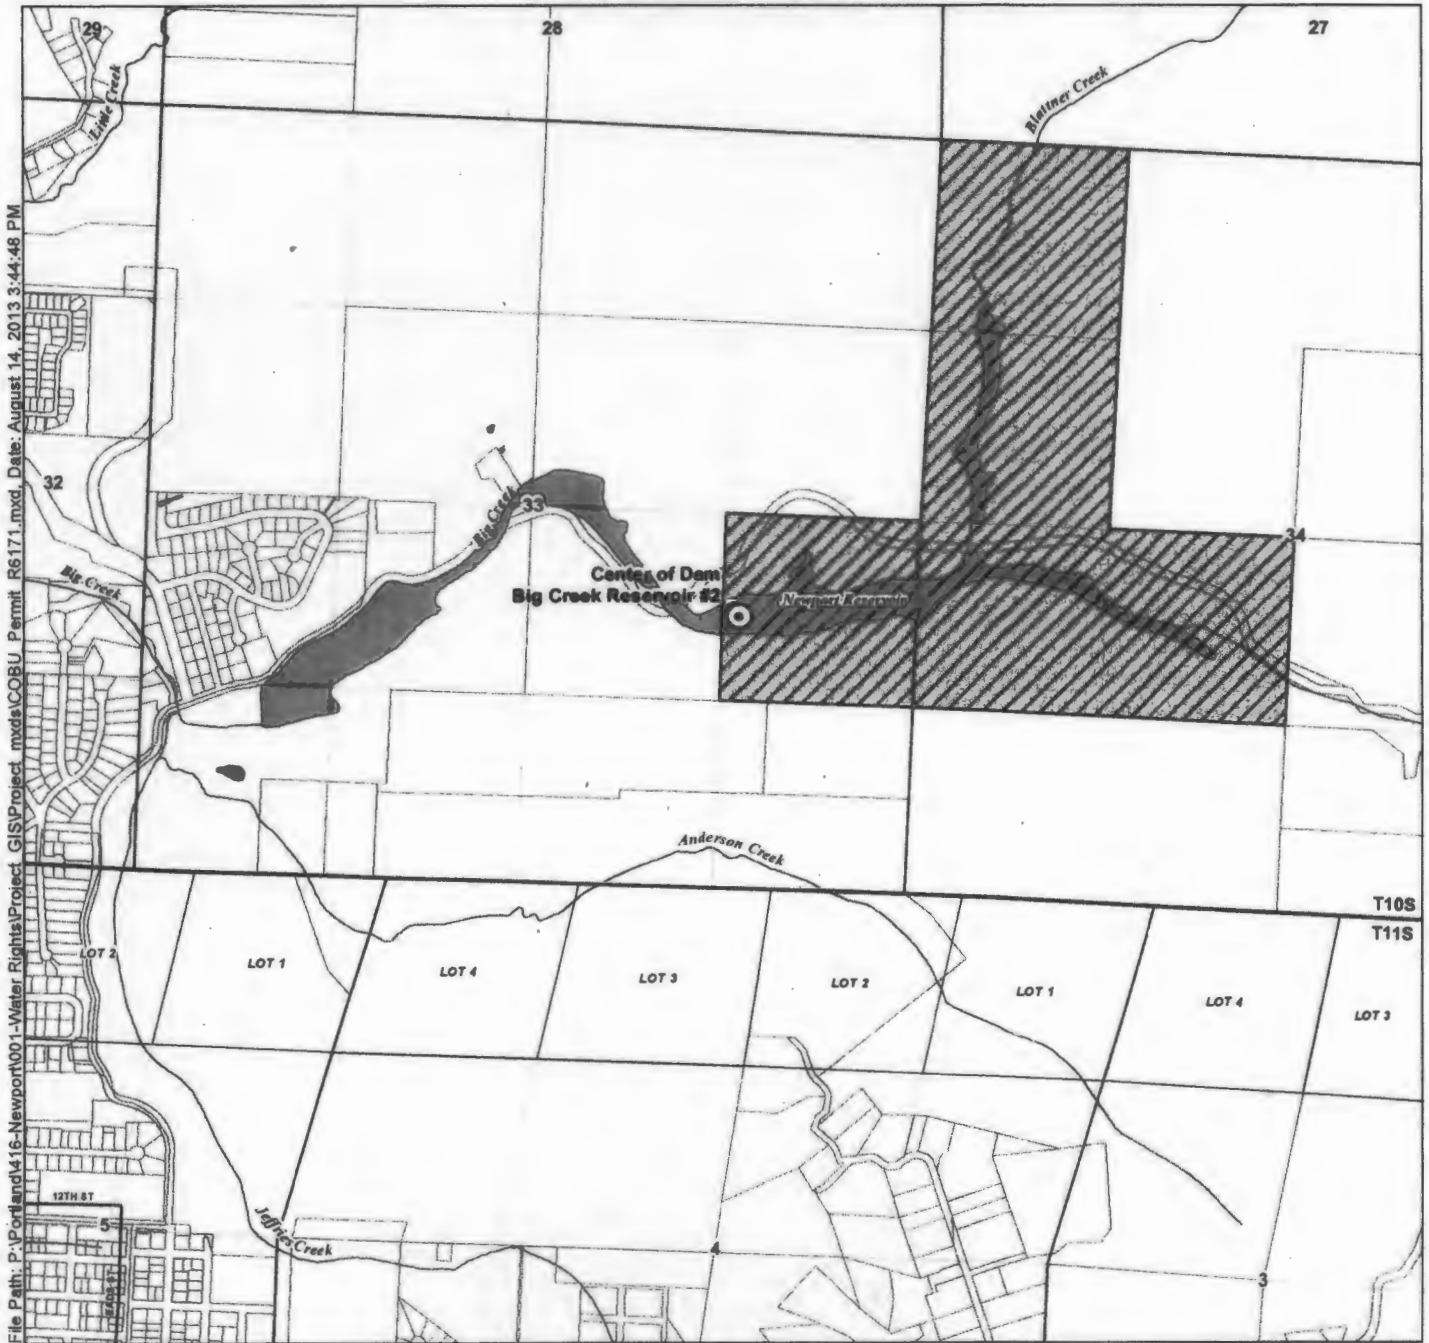


LEGEND

- Point of Diversion (POD)
- Place of Use (POU)
- Government Lot
- Tax Lot
- Road
- Watercourse
- Waterbody

POP Location Description

Big Creek Reservoir #2, Center of Dam
Located 1,875 feet North and 1,220 feet West from the SE corner of Section 33, Township 10 South, Range 11 West (W.M.)

Certified Water Rights Examiner Stamp

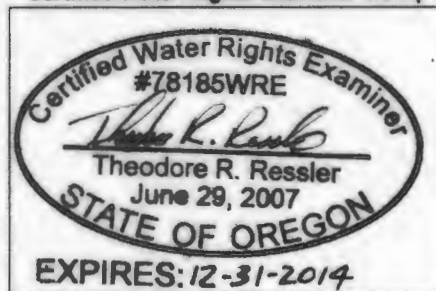

This location is

Disclaimer

RECEIVED

NOV 01 2013

WATER RESOURCES DEPT
SALEM, OREGON



0 660 1,320
Feet

