


Claim of Beneficial Use Point of Diversion Map

Permit S-38220, Application S-52204

Township 10 & 11 South, Range 11 West (W.M.)

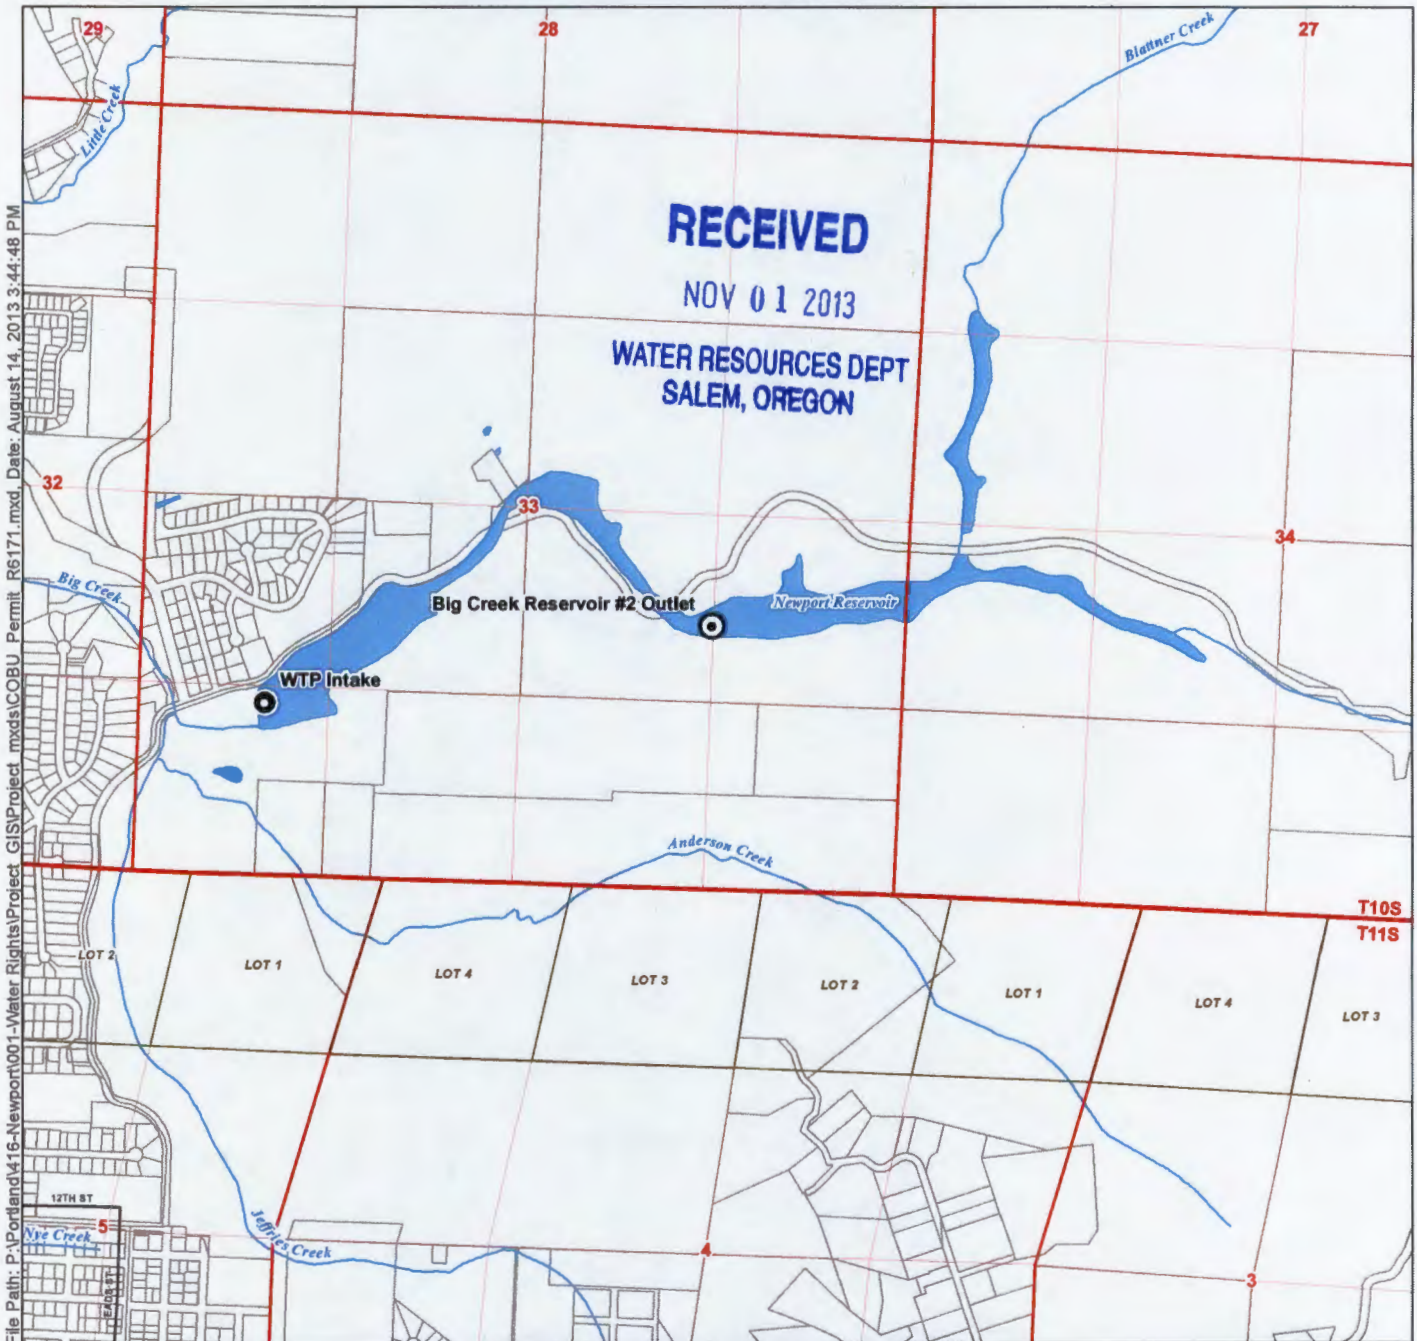

LEGEND


- ⊙ Point of Diversion (POD)
- Point of Re-Diversion
- Government Lot
- ⊕ Tax Lot
- Road
- ~ Watercourse
- Waterbody

Location Description

Point of Diversion, Big Creek Reservoir #2 Outlet
Located 1,825 feet North and 1,330 feet West from the SE corner of Section 33, Township 10 South, Range 11 West (W.M.)

Point of Re-Diversion, WTP Intake
Located 1,190 feet North and 870 feet East from the SW corner of Section 33, Township 10 South, Range 11 West (W.M.)

Certified Water Rights Examiner Stamp

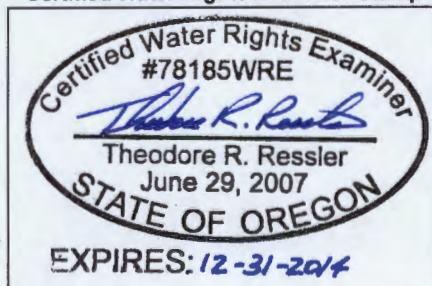

Disclaimer

This map was prepared for the purpose of identifying the location of a water right only and it is not intended to provide legal dimensions or location of property ownership lines.

Map Notes


Date: August 17, 2013
Data Sources: BLM, NHD, ESRI
Prepared By: GSI Water Solutions, Inc.



Claim of Beneficial Use Place of Use Map

Permit S-38220, Application S-52204


Township 10 & 11 South, Range 11 West (W.M.)

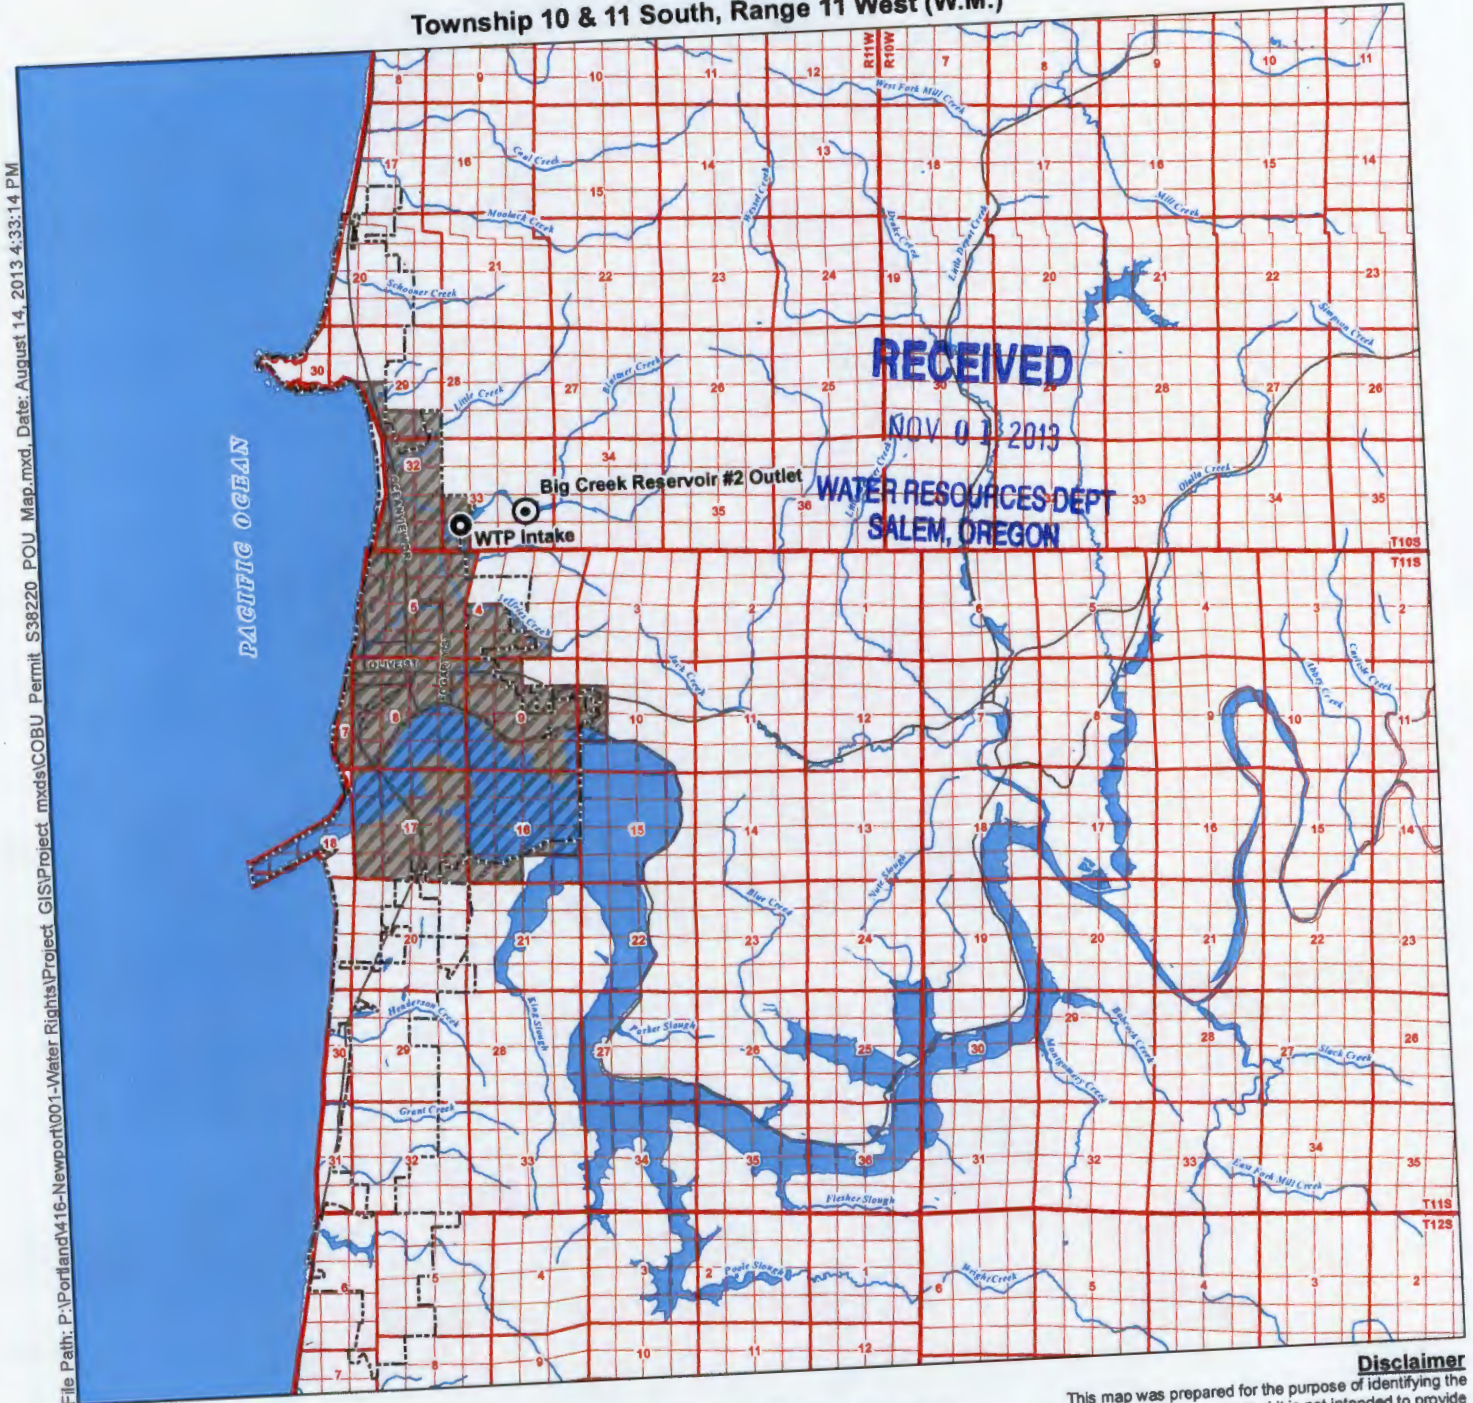

LEGEND

- Point of Diversion (POD)
- Point of Re-Diversion
- Place of Use (POU)
- Newport City Limits
- Road
- Watercourse
- Waterbody


Certified Water Rights Examiner Stamp

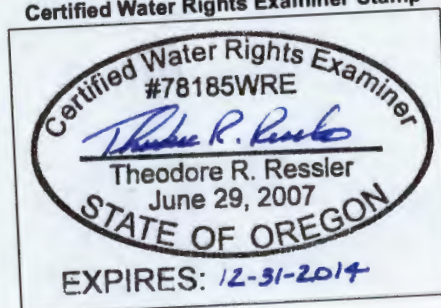

Disclaimer
This map was prepared for the purpose of identifying the location of a water right only and it is not intended to provide legal dimensions or location of property ownership lines.

Map Notes

Date: August 29, 2013
Data Sources: BLM, NHD, ESRI
Prepared By: GSI Water Solutions, Inc.

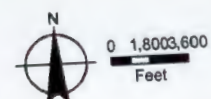

File Path: P:\Portland\16-Newport\001-Water Rights\Project GIS\Project mxd\COBU Permit S38220 POU Map.mxd, Date: August 14, 2013 4:33:14 PM