


T. 8 S., R. 4 W., Sect 34, W.M.
 T. 9 S., R. 4 W., Sect 03, W.M.
 Polk County, Oregon
 T-9870


RECEIVED
 SEP 20 2007
 WATER RESOURCES DEPT
 SALEM, OREGON

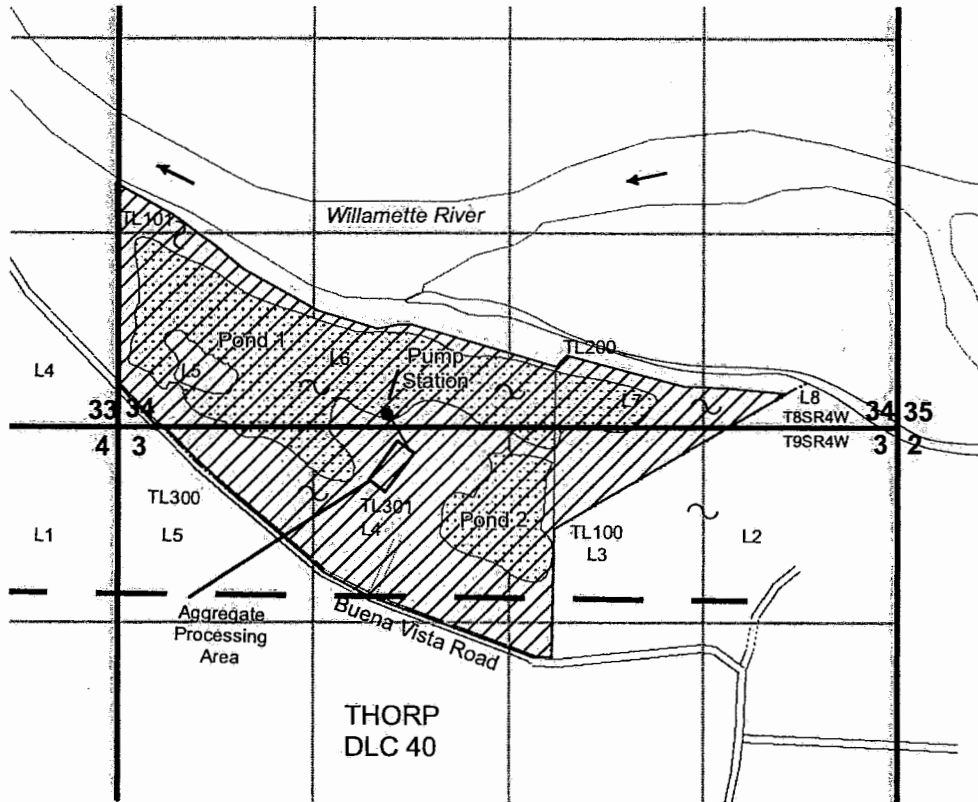

Pump Station (Point of Diversion) located 1,825 feet E and 85 feet N of SW Corner Section 34, T8S, R4W, W.M.

Legend

- POD
- Quarter/Quarter
- Sections
- Roads
- - - DLC
- Property Boundary
- ▨ Place of Use
- ▤ Pond

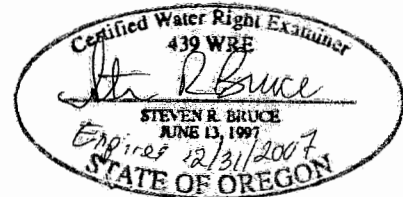

This map is not intended to provide legal dimensions or locations of property ownership lines.

Claim of Beneficial Use Map

J.C. Compton
 Polk County, Oregon

GEOENGINEERS

Figure 1

Map Date: September 17, 2007

Path: P:\1212702003\000\GIS\12702003000\Fig1.mxd

PORT