


TOWNSHIP 10 SOUTH, RANGE 17 EAST, W.M.

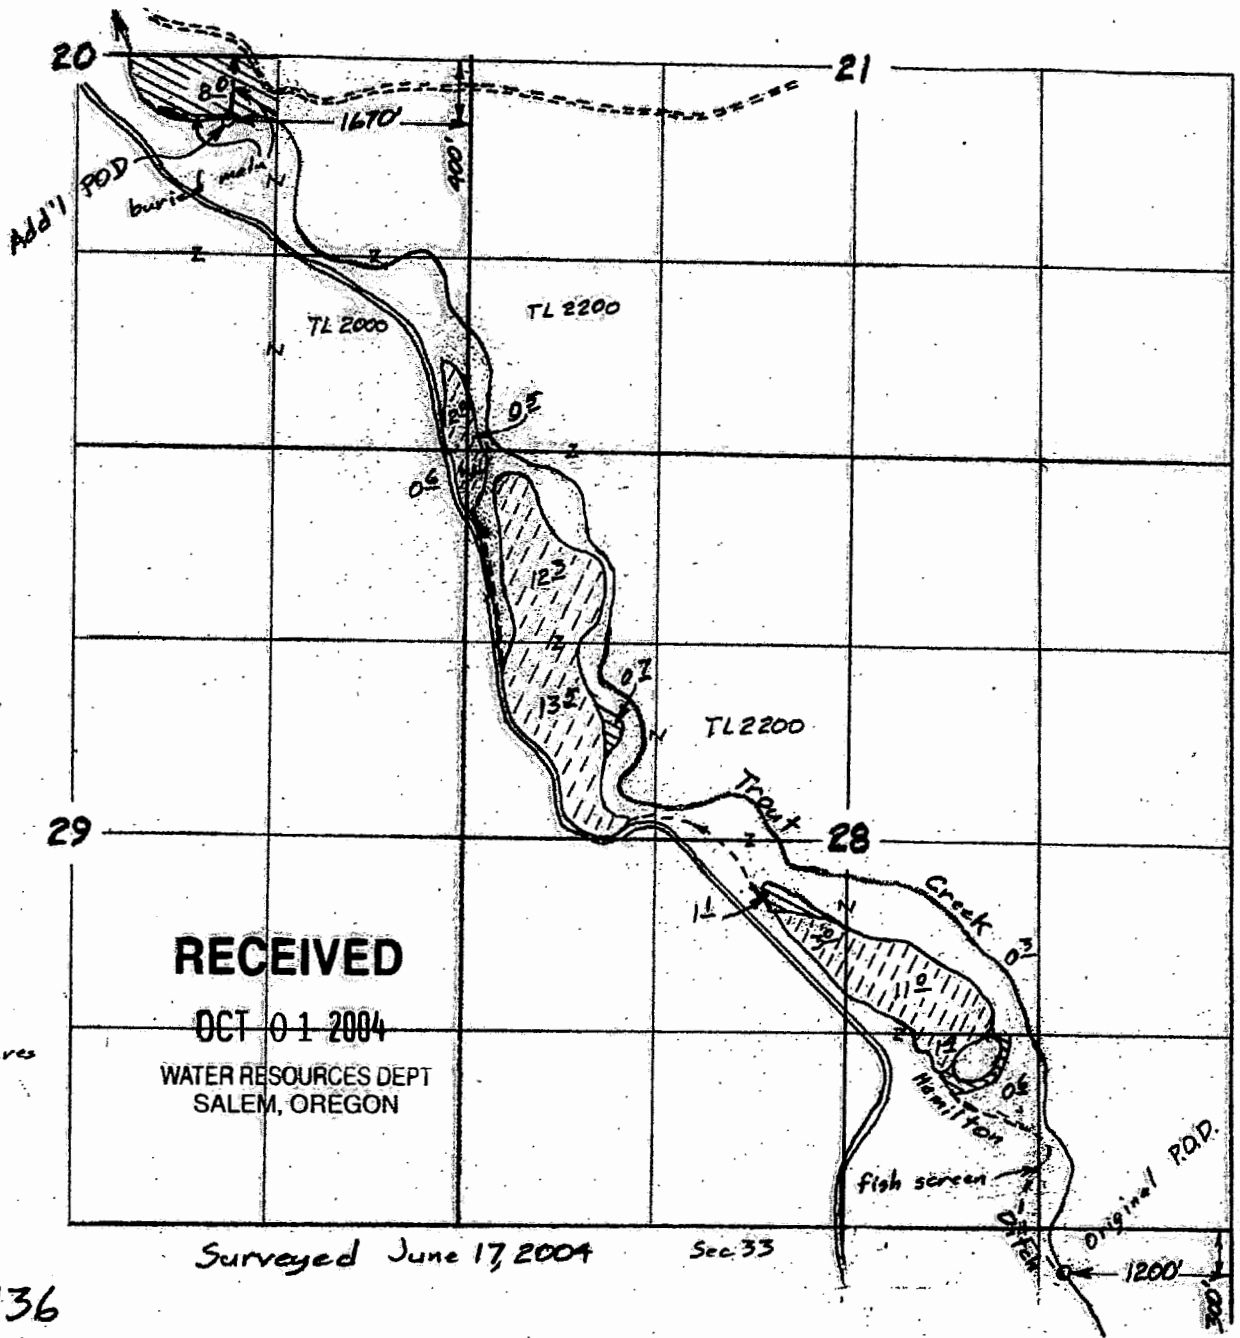

Scale 1" = 1320'  
(4" = 1 mile)

**RECEIVED**

OCT 01 2004

WATER RESOURCES DEPT  
SALEM, OREGON

- ⊗ To 103 acres
- ⊙ C-2236

T-9136

Claim of Beneficial Use Map  
for  
**CORRY WRIGHT**



This map is for the purpose of locating a water right only and has no intent to provide legal dimensions or the location of property lines.

**ESTES SURVEYS, LLC**  
 PO Box 17519      60382 Arnold Rd  
 Salem, OR 97305-7519      Bend, OR 97702  
 (503) 585-7593      (541) 382-7391