



RECEIVED 21-22

SEP 30 1984

This drawing is an exhibit for a Final Proof Survey. It is not a Land Survey. Property lines and/or other lines of occupation shown hereon are not represented by the undersigned to meet accuracy standards of Land Surveys.

DIVERSION POINTS

- WELL NO. 1: S 88° E, 733' FROM N 1/4 CORNER, SECTION 28
WELL NO. 2: N 62° 30' E, 632' FROM S 1/4 CORNER, SECTION 21
WELL NO. 3: N 49° E, 713' FROM S 1/4 CORNER, SECTION 21
WELL NO. 4: S 82° E, 756' FROM N 1/4 CORNER, SECTION 28
WELL NO. 5: N 81° 30' E, 1485' FROM S 1/4 CORNER, SECTION 21

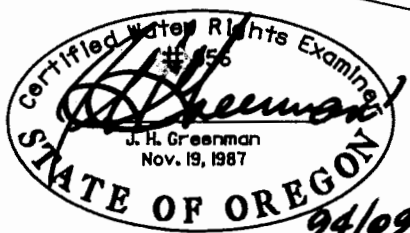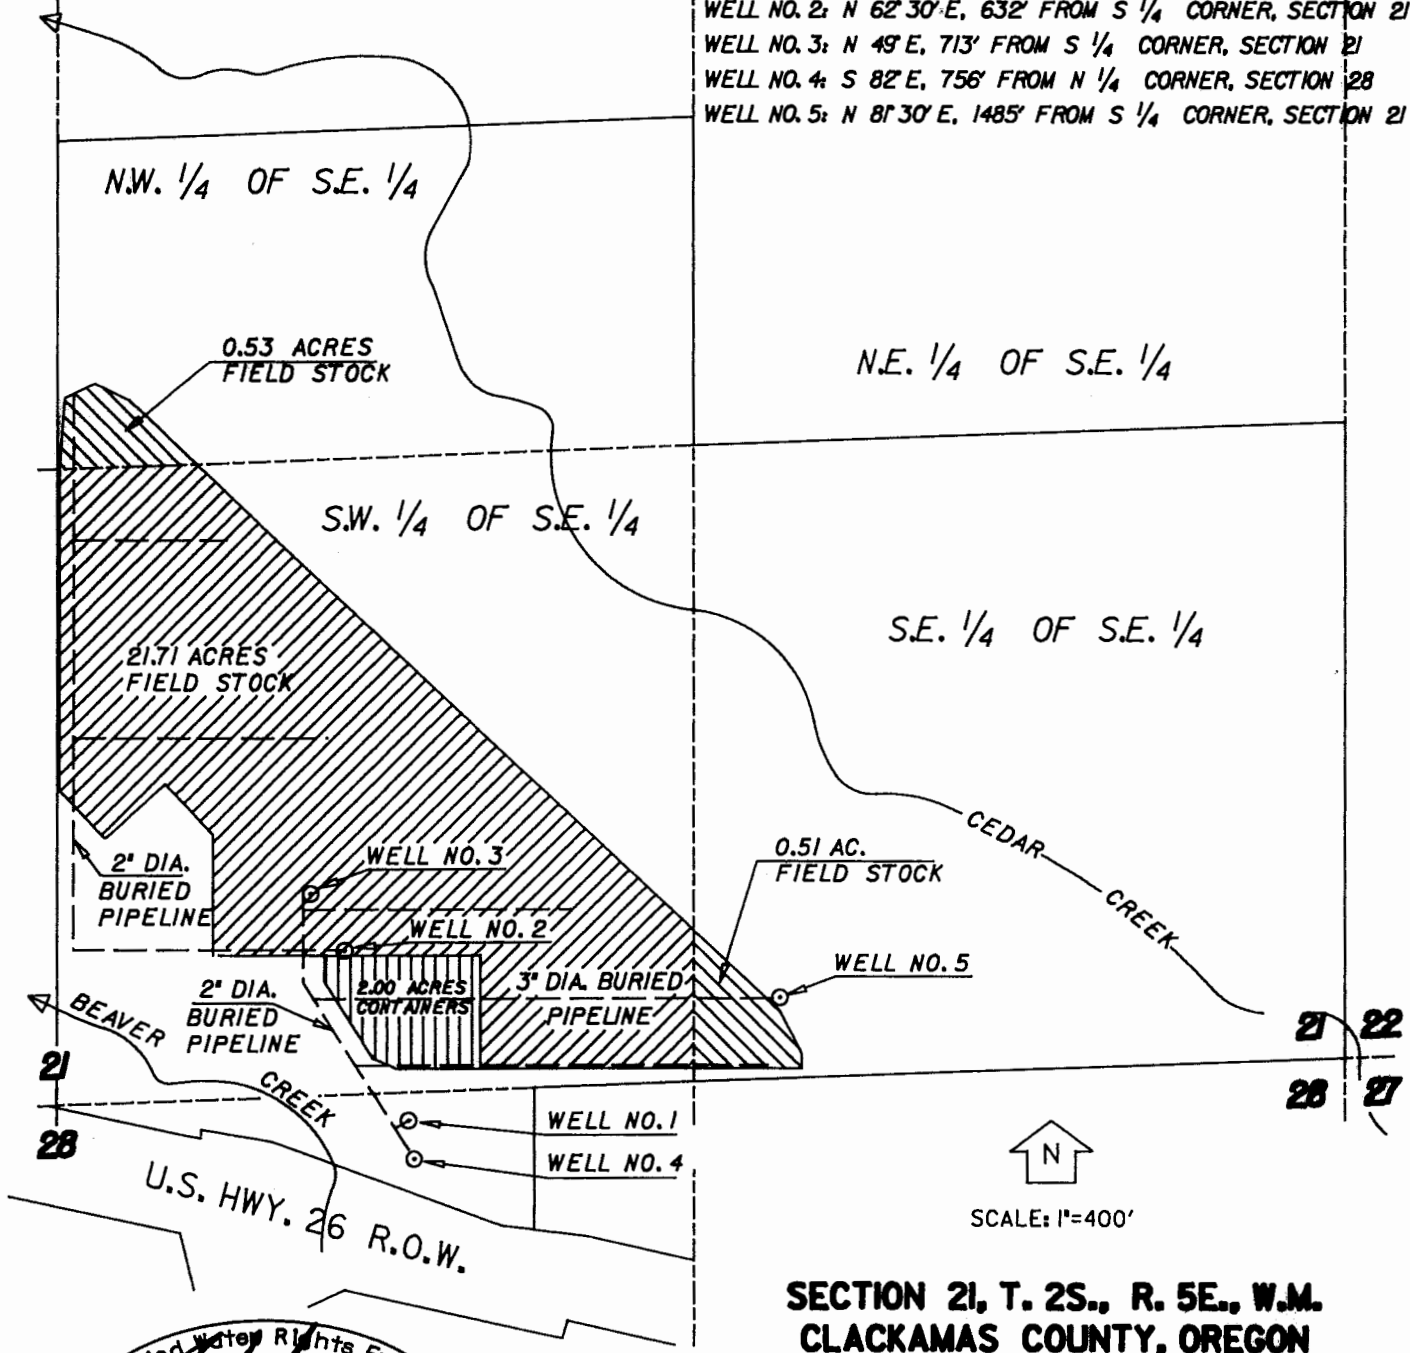

SECTION 21, T. 2S., R. 5E., W.M.
CLACKAMAS COUNTY, OREGON

Application No. G-12373
Permit No. G-11251



**HANER, ROSS &
SPORSEEN, INC.**
15 S.E. 82ND DRIVE
GLADSTONE, OREGON 97027

**PORTER NURSERY
GROUND WATER RIGHT
FINAL PROOF SURVEY**

622Y

File: 622yfn.dgn 9/29/94