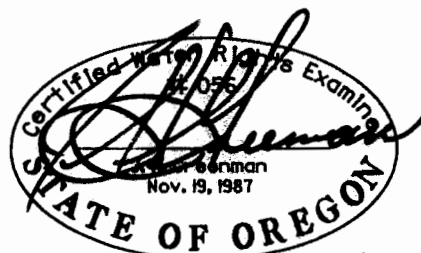



RECEIVED

FEB 27 1997


WATER RESOURCES DEPT
SALEM, OREGON

97/02/21

This drawing is an exhibit accompanying a Report of Beneficial Use submitted as part of the evidence showing perfection of a Water Right. It is not a Land Survey. Property lines and/or other lines of occupation shown hereon are not represented by the undersigned to meet accuracy standards used to prepare Land Surveys.

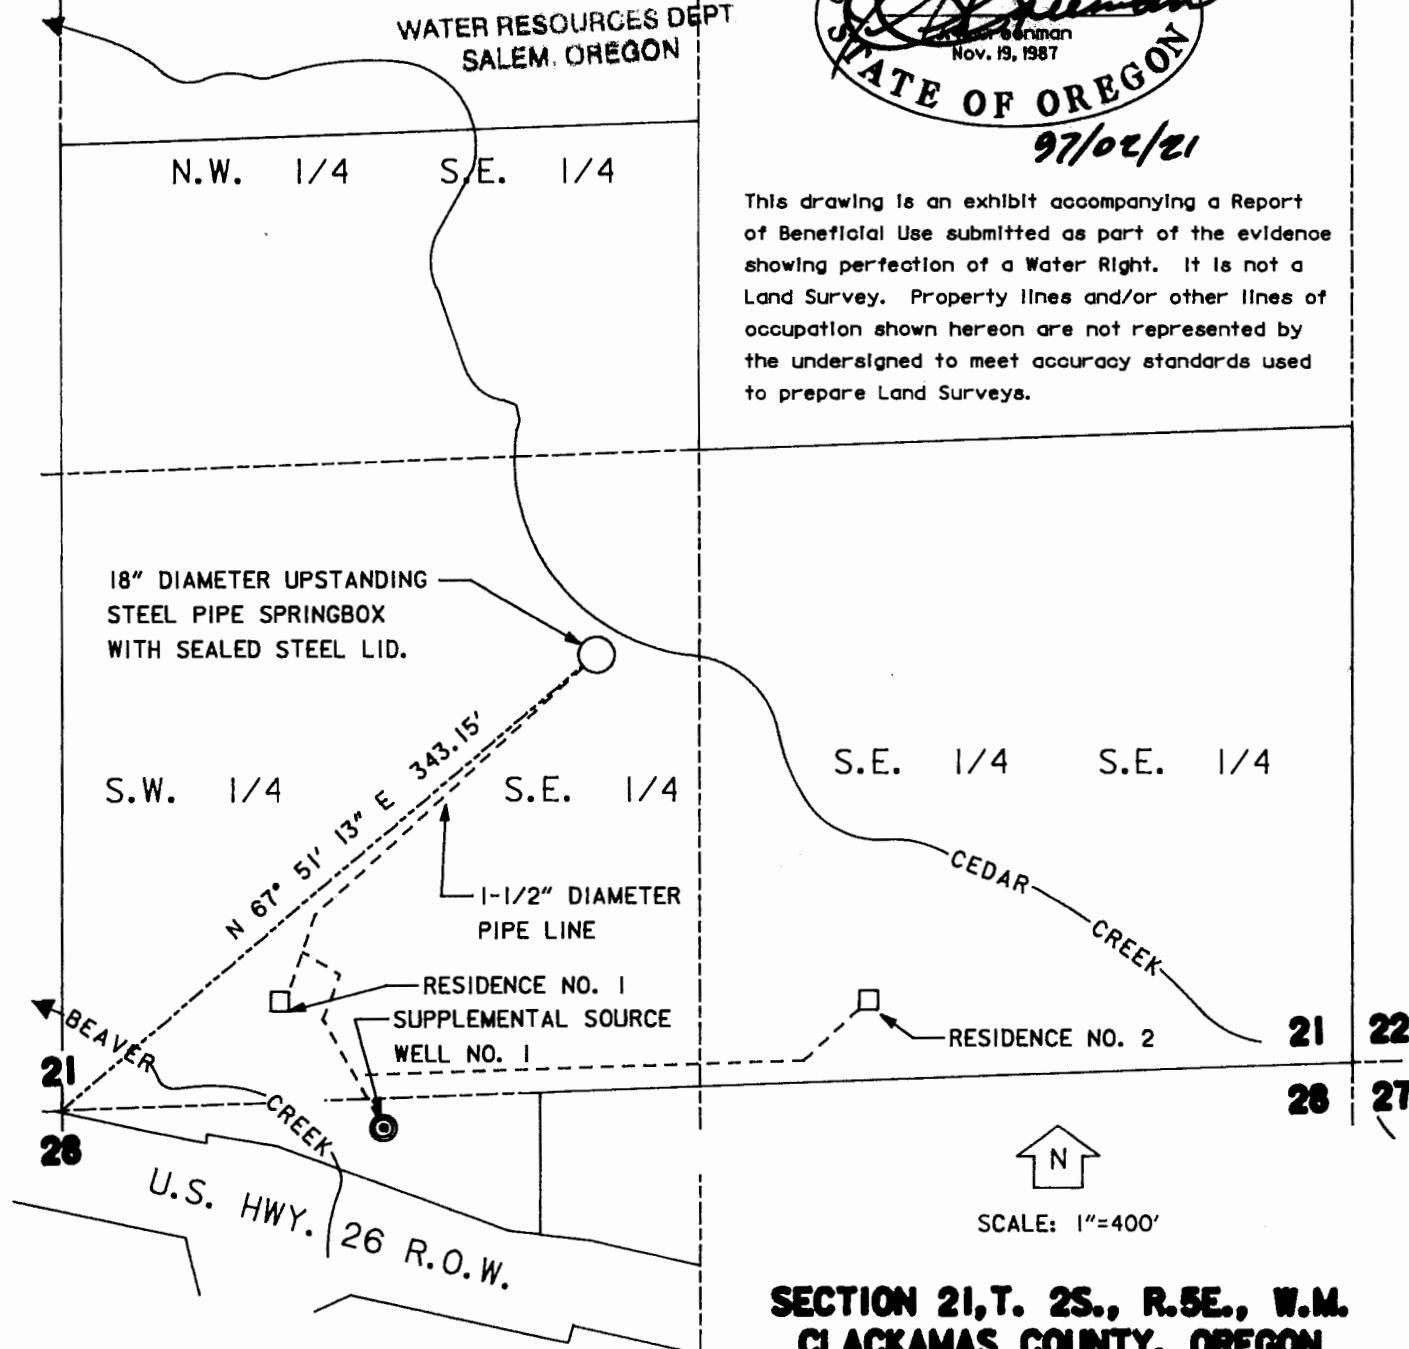

**SECTION 21, T. 2S., R. 5E., W. M.
CLACKAMAS COUNTY, OREGON**

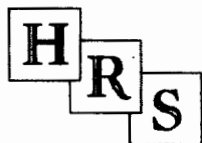Application No. S-71088Permit No. 52241

**HANER, ROSS &
SPORSEEN, INC.**
15 S.E. 82ND DRIVE
GLADSTONE, OREGON 97027

**PORTER NURSERY
SURFACE WATER RIGHT
FINAL PROOF SURVEY**

622Y