


SCALE: 1"=1320'

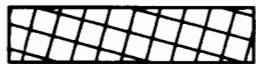

Lands irrigated under Certificate number 42444.



Lands irrigated under Certificate number 79512.




Buried mainline

**RECEIVED**

JUL 13 2011

WATER RESOURCES DEPT  
SALEM, OREGON

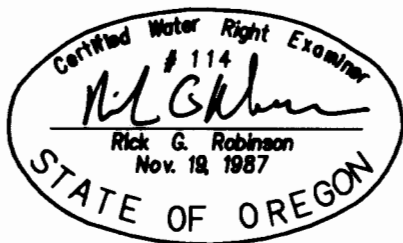

July 5, 2011  
**FINAL PROOF MAP FOR  
 TRANSFER OF PLACE OF USE  
 FOR  
 MIKE BECKER**

BY  
**BAGETT - GRIFFITH & BLACKMAN  
 2006 ADAMS AVENUE  
 LAGRANDE, OREGON 97850**

NOTE: The preparation of this map was for the purpose of identifying the location of water rights and has no intent to provide dimensions or location of property ownership lines. Location information shown hereon was furnished by the applicant.

PERMIT NUMBER T-10452

APPLICATION NO. T-10452