


T.4S. R.1W. Sec. 7 & 18, and T.4S. R.2W. Sec. 12 & 13, W.M.

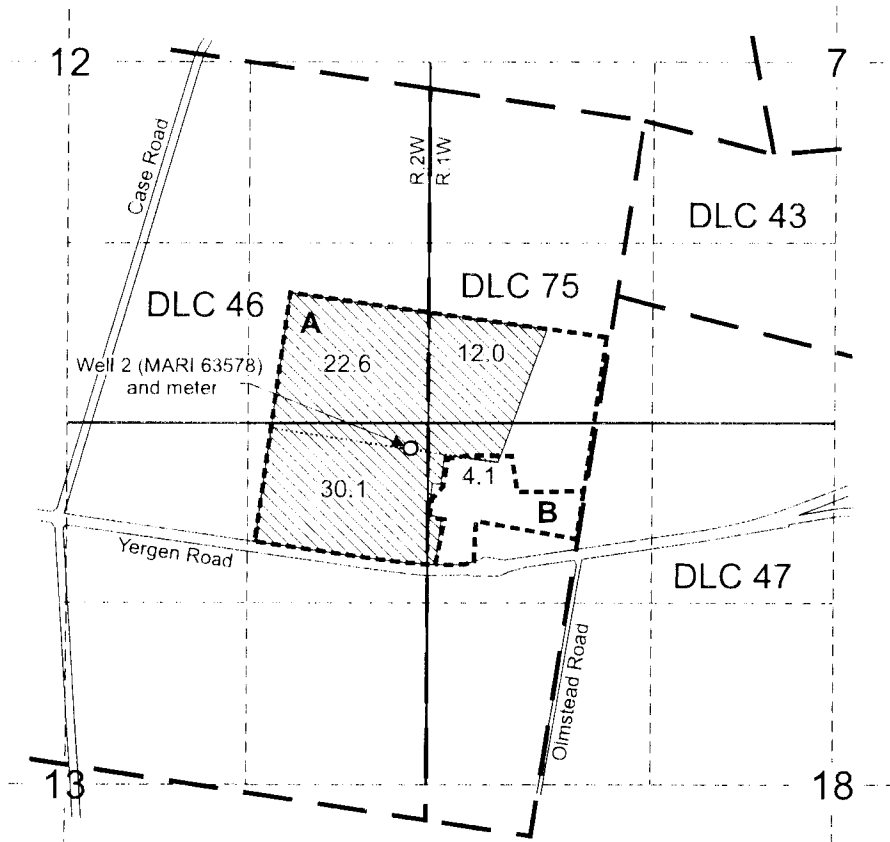

RECEIVED

SEP 13 2013

WATER RESOURCES DEPT
SALEM, OREGON

Well 2 (MARI 63578) is located 2,840 feet north and 870 feet west from the SE corner, DLC 75.

Area (68.8 Acres) irrigated under T-11142.


Tax lot boundary

Irrigation mainline

Donation Land Claim boundary

A TL 4 2W 13 100

B TL 4 1W 18 900

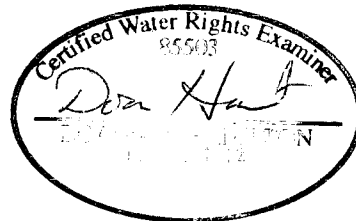

RENEWS June 30, 2015

Scale: 1" = 1,320'



This map was prepared for the purpose of identifying the location of a water right only and is not intended to provide legal dimensions or location of property ownership lines.

Claim of Beneficial Use Map
T-11142

Twila M. Wettstein Trust
T.4S. R.1W. Sec. 7 & 18, and
T.4S. R.2W. Sec. 12 & 13, W.M.

Pacific Hydro-Geology Inc.

08/2013