


T.5S., R.1W., W.M

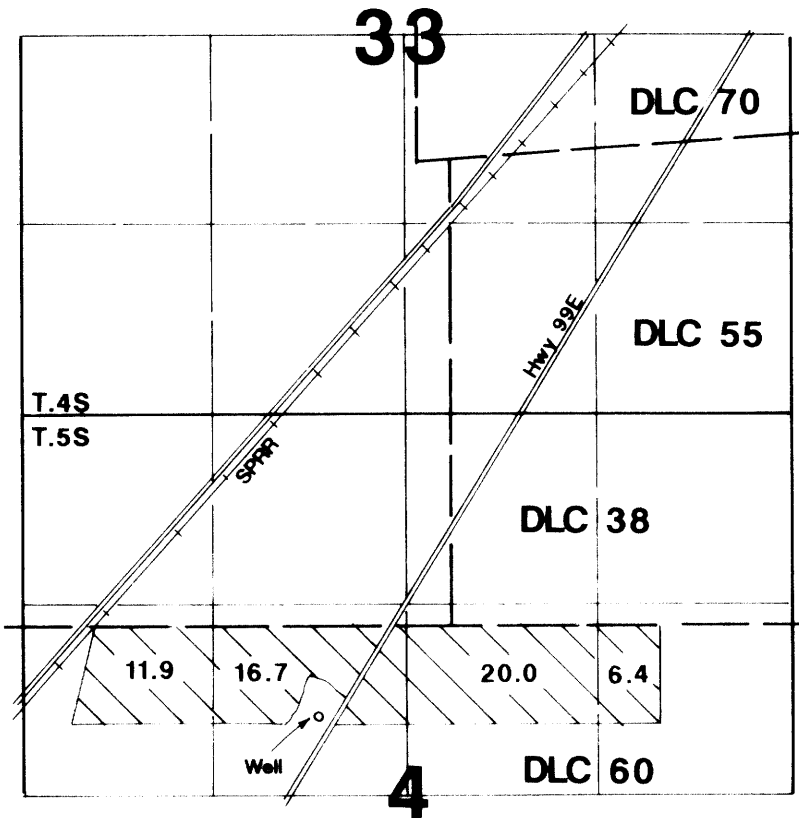

Well located 890'W & 595'S from SW corner DLC 38.

Final Proof Survey

Application #: G-11781 Permit #: G-10882

In Name Of

Joe E. Bronec

Surveyed on September 10, 1993 by JM Schuette

THIS MAP WAS PREPARED FOR THE PURPOSE OF IDENTIFYING THE LOCATION OF A WATER RIGHT ONLY AND IS NOT INTENDED TO PROVIDE LEGAL DIMENSIONS OR LOCATION OF PROPERTY OWNERSHIP LINES.