



T. 1 N. R. 13 E. W.M.

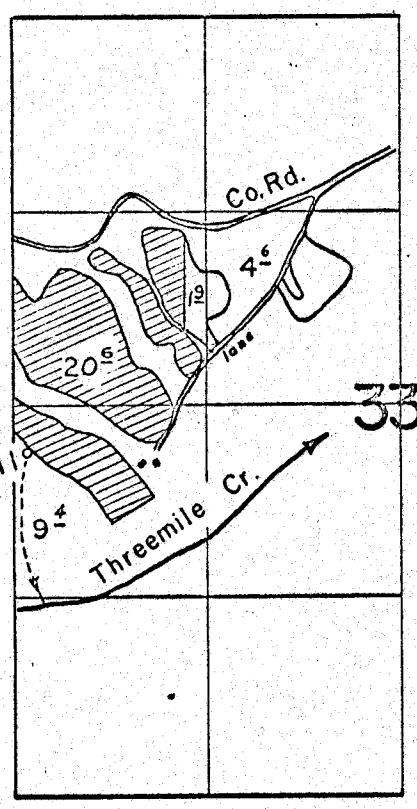

310' S. & 78' E. Well
from W/4 Co-
Sec. 35

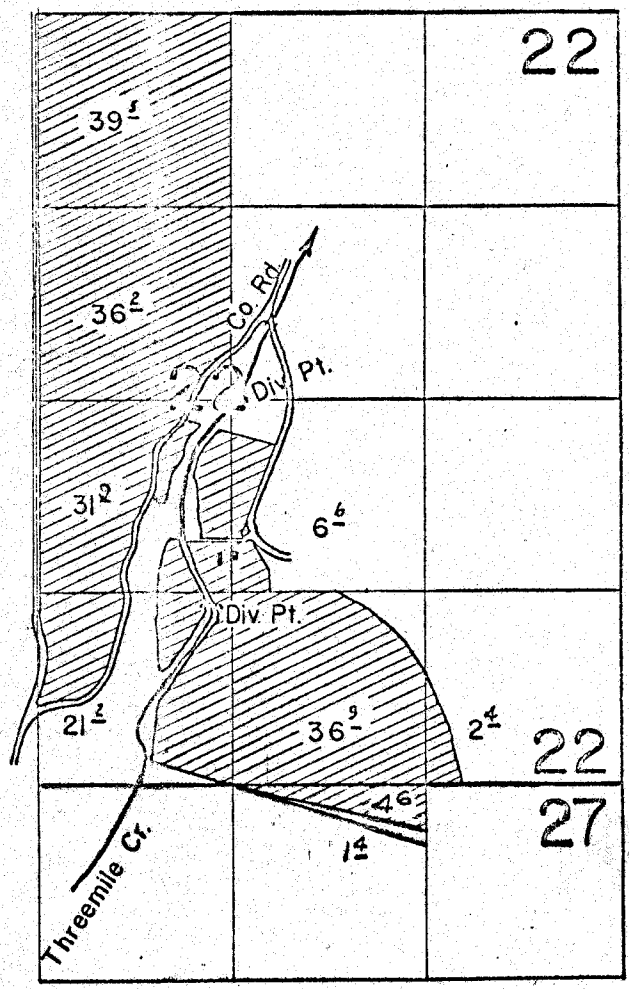

Application No. G-7916
Permit No. G 8540

FINAL PROOF SURVEY
UNDER

RECEIVED
MAR 11 1977
WATER RESOURCES DEPT
SALEM, OREGON

Application No. ~~6-1600~~ Permit No. ~~6-1466~~
IN NAME OF

ROBERT E. & ARTHUR E. SANDERS

Surveyed April 8, 1963, by *Darryl F. Bousch*