


T7S R2W WM

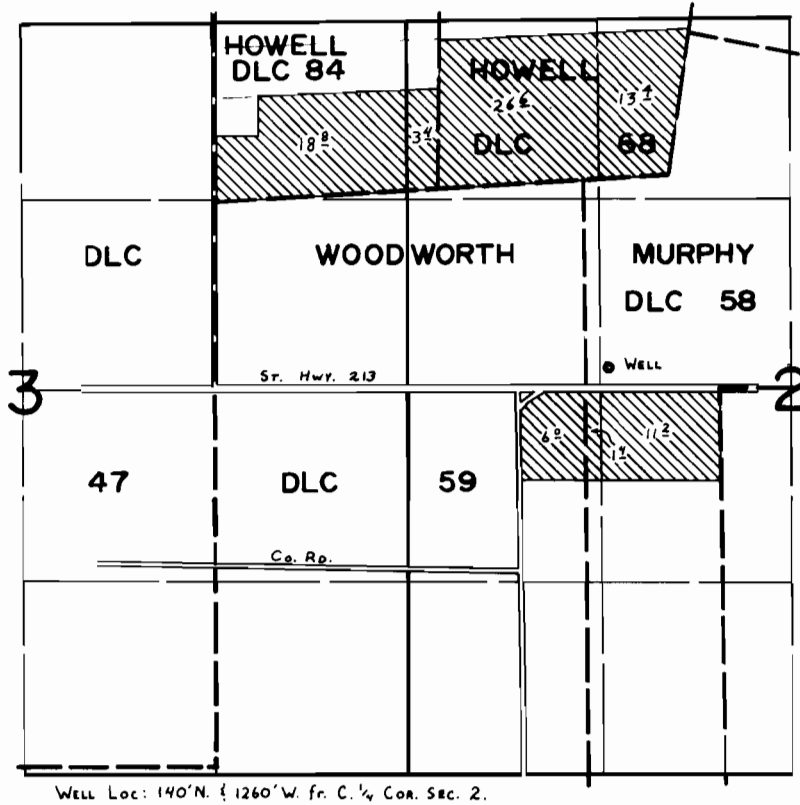

FINAL PROOF SURVEY UNDER

Application No. ~~G-8554~~ Permit No. ~~G-7867~~...
IN NAME OF

.....EDWARD A. HARI.....

Surveyed ...May...2... 19.80., byC. L. HARRIS.....