


T. 34 S., R. 6 & 7 1/2 E., W.M.

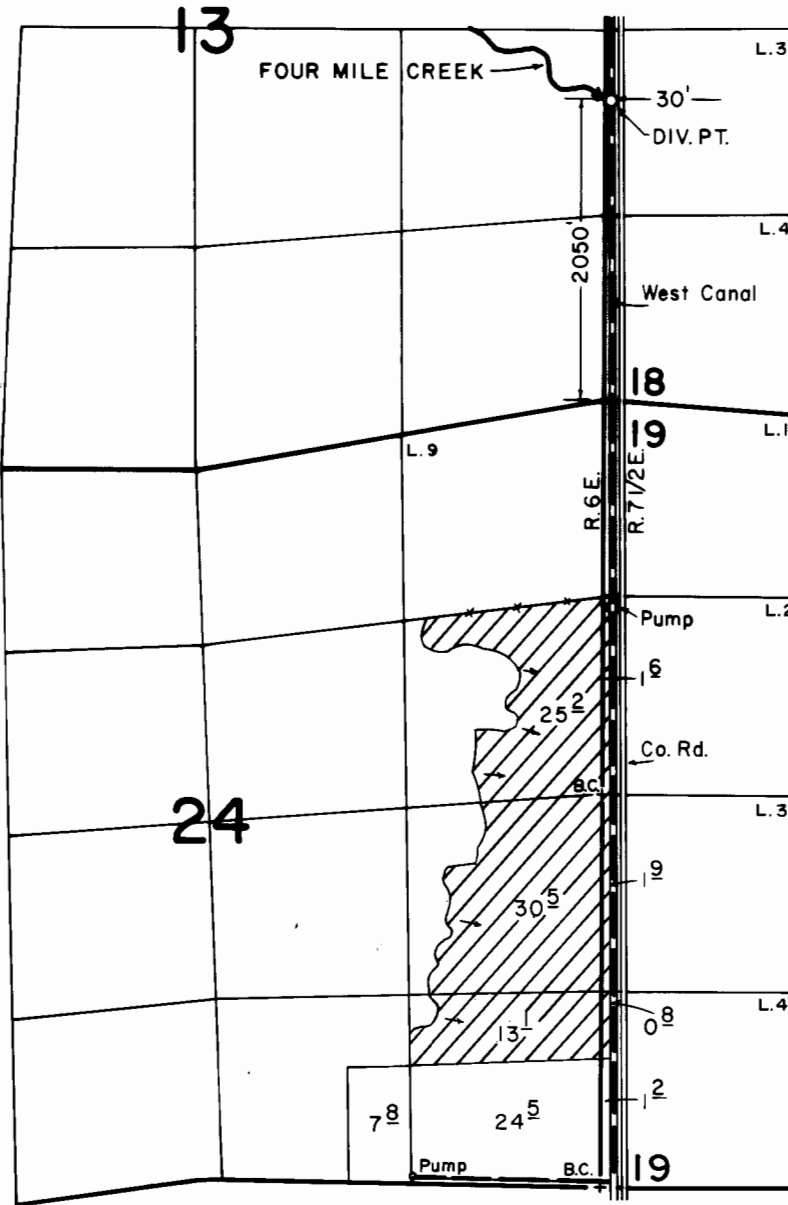

SCALE: 1" = 1320'

FINAL PROOF SURVEY UNDER

Application No. 62918... Permit No. 46846...
IN NAME OF

MONTGOMERY GILL RANCH COMPANY

Surveyed SEPT. 14 1989, by B. W. BISHOP...