


**T. 36S., R. 12E., W.M.**

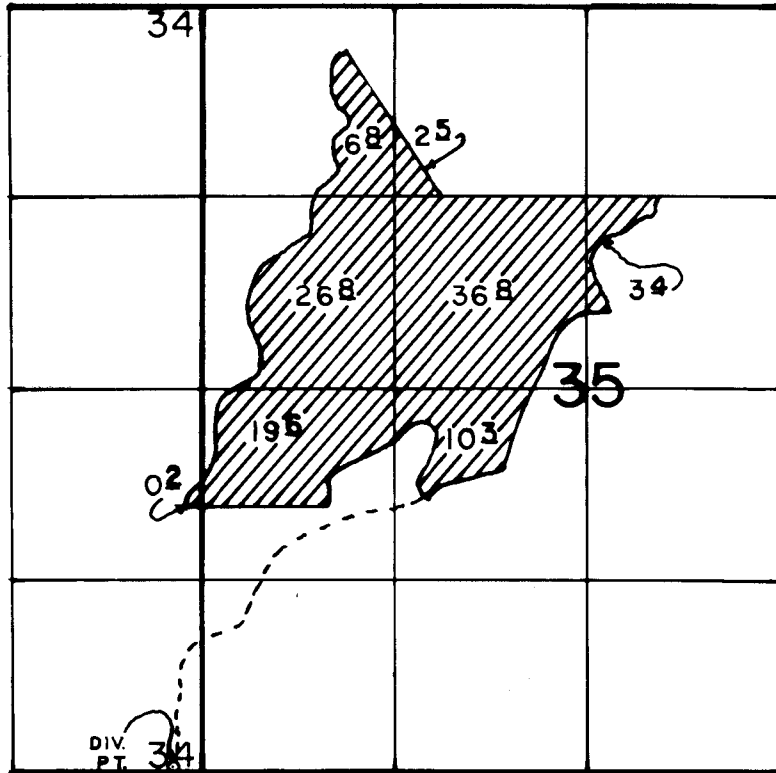

DIV. PT. LOC: 30' N & 180' W FROM SE COR. OF SEC 34.

SCALE: 1" = 1320'

**FINAL PROOF SURVEY**

UNDER

Application No. 52803 Permit No. 39181  
IN NAME OF

FLYNN BROTHERS

Surveyed JUNE 28, 1994, by R.M. SUTTERFIELD

1067