


T. 26 S., R. 16 E., W.M.

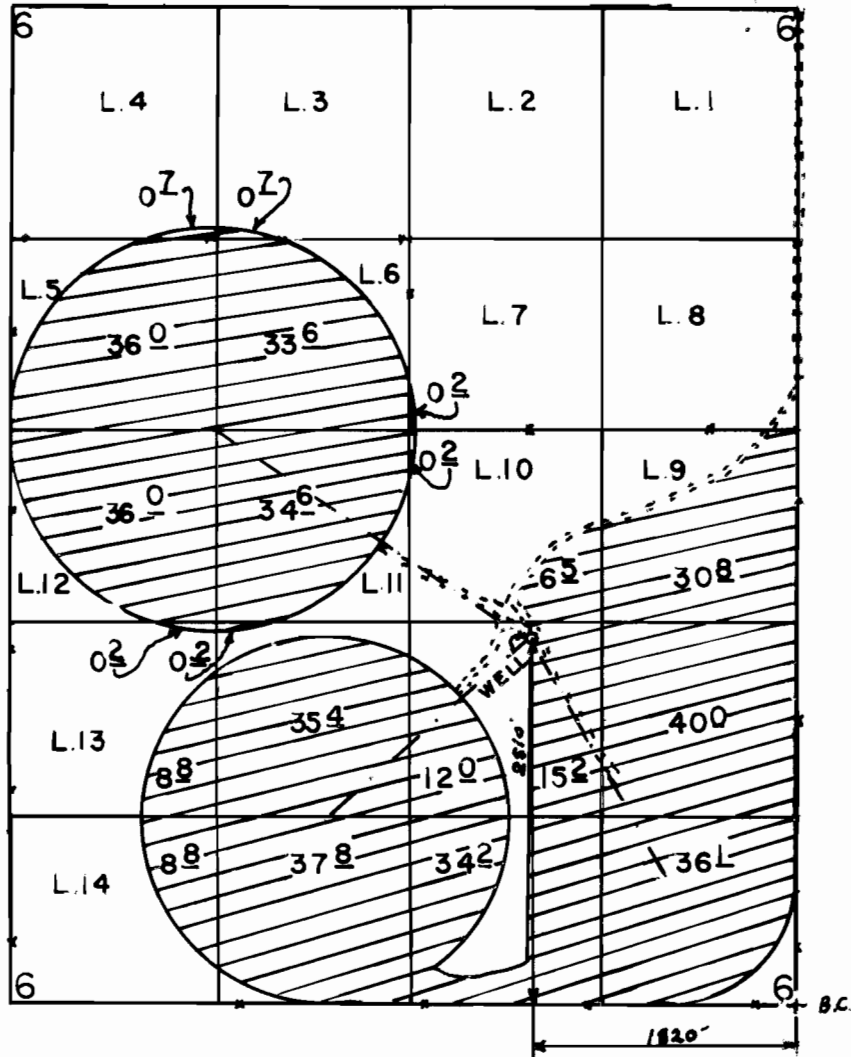

SCALE: 1" = 1320'

**FINAL PROOF SURVEY**  
UNDER

Application No. 9-10940 Permit No. 9-10099...  
IN NAME OF

*CHARLES NOFZIGER*

Surveyed DEC. 8... 1998., by R.M. SHUTTERFIELD