


Claim of Beneficial  
Use Map  
for  
Durgan Ranch, LLC  
T-9124


- ⊗ C-623 1878  
150± acres
- ⊗ C-623 1898  
44± acres
- ⊗ C-607 1885  
130± acres
- ⊗ C-13493 1936  
33± acres

Scale 1"=1320'  
(4"=1 mile)

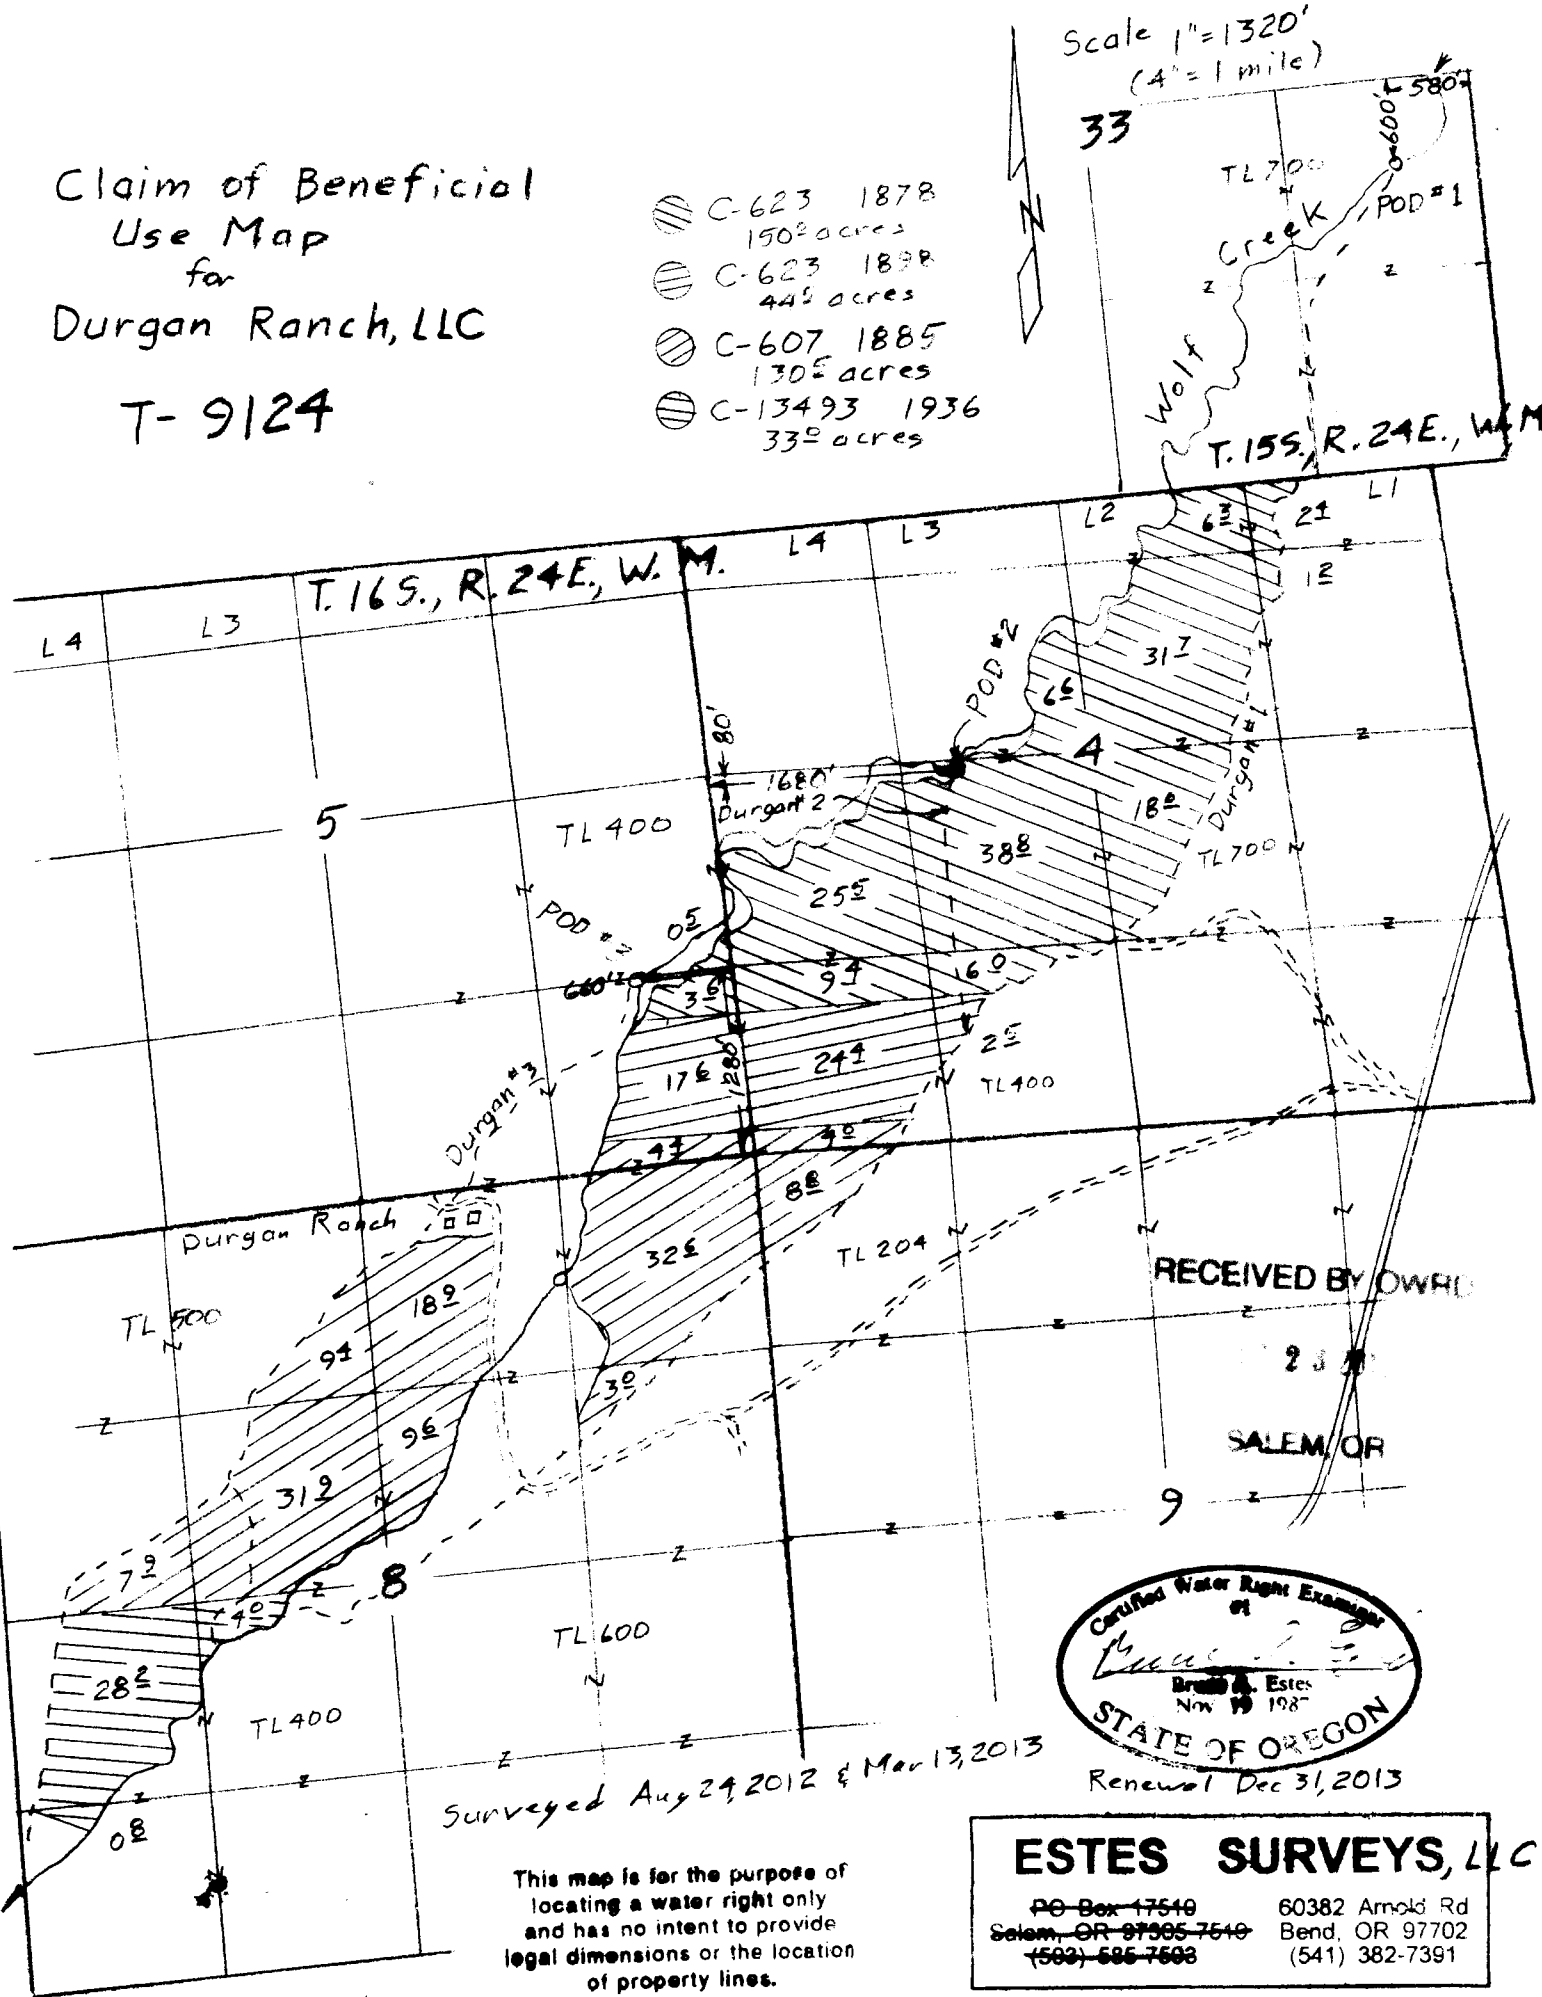

RECEIVED BY OWRD

SALEM, OR

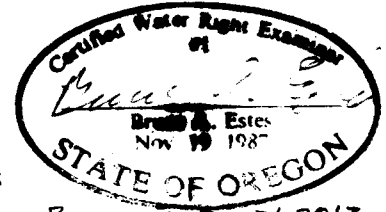

Renewal Dec 31, 2013

Surveyed Aug 24, 2012 & Mar 13, 2013

This map is for the purpose of  
locating a water right only  
and has no intent to provide  
legal dimensions or the location  
of property lines.

**ESTES SURVEYS, LLC**  
 PO Box 17540      60382 Arnold Rd  
 Salem, OR 97305-7540      Bend, OR 97702  
 (503) 685-7608      (541) 382-7391