
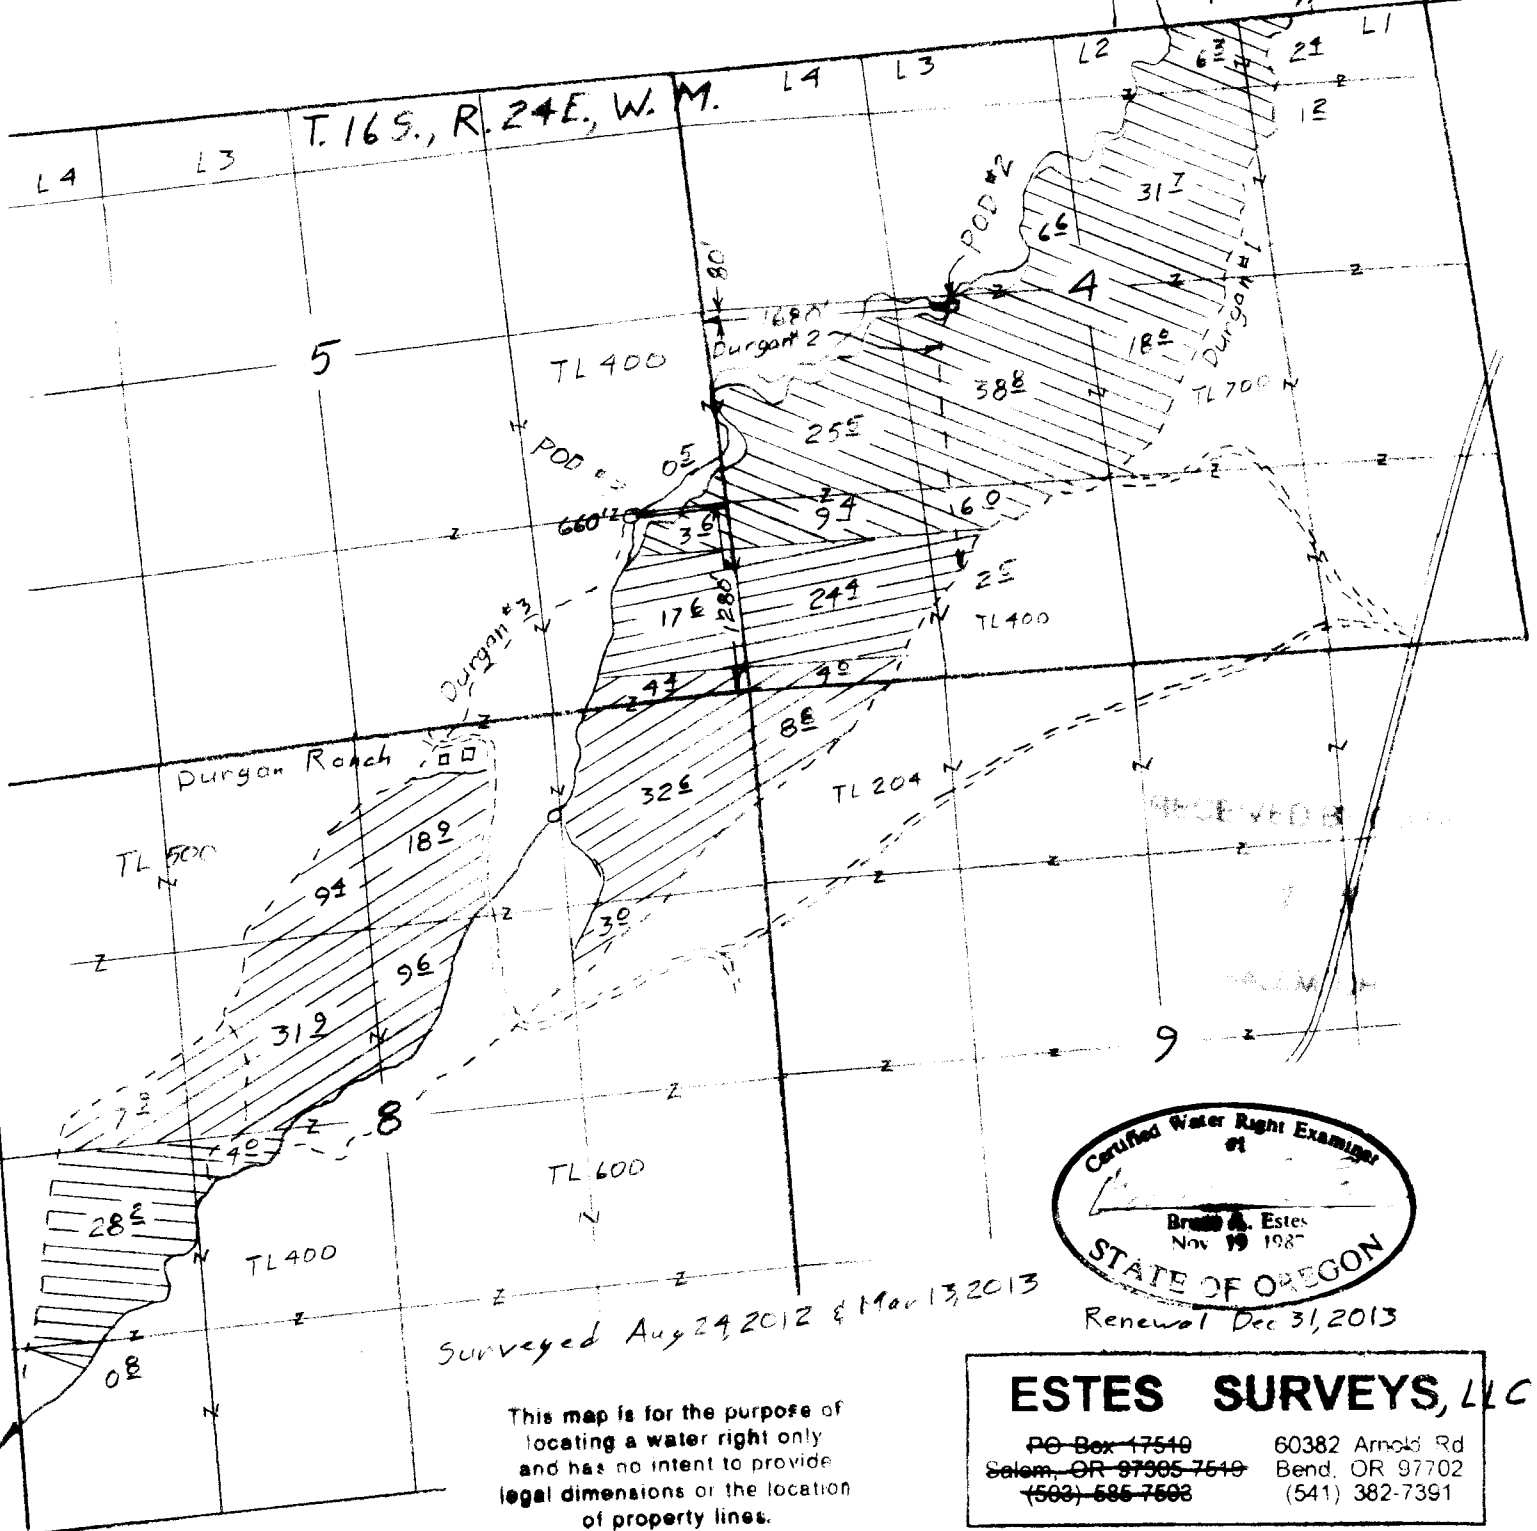



Claim of Beneficial
Use Map
for
Durgan Ranch, LLC
T-9124

- ⊘ C-623 1878
150± acres
- ⊘ C-623 1888
44± acres
- ⊘ C-607 1885
130± acres
- ⊘ C-13493 1936
33± acres

Scale 1"=1320'
(4"=1 mile)

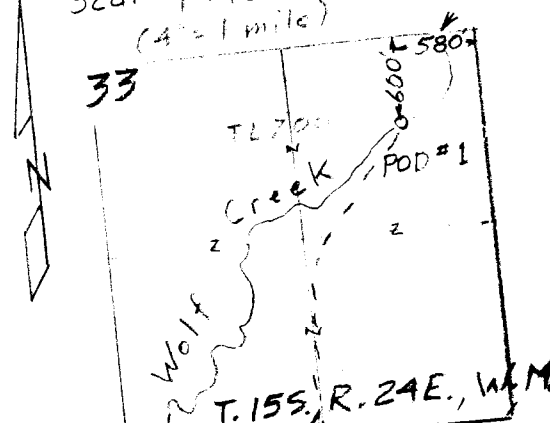

Surveyed Aug 24, 2012 & Mar 13, 2013

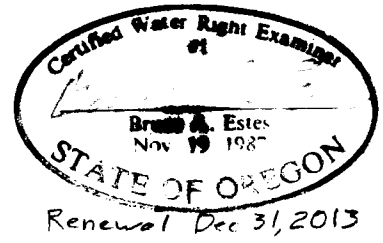

This map is for the purpose of
locating a water right only
and has no intent to provide
legal dimensions or the location
of property lines.

ESTES SURVEYS, LLC
 PO Box 17510 60382 Arnold Rd
 Salem, OR 97305-7510 Bend, OR 97702
 (503) 686-7608 (541) 382-7391