


T.16 S.R.1 W.W.M.

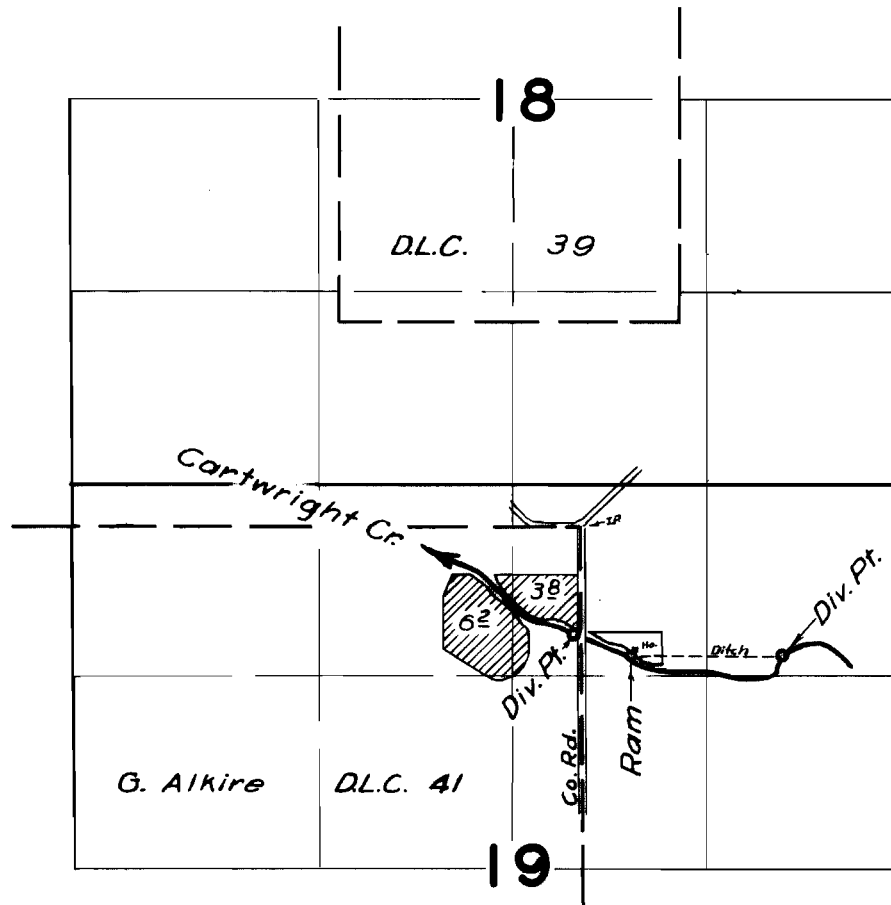

FINAL PROOF SURVEY

UNDER

Application No. 20649 Permit No. 16152
IN NAME OF

Otto Lydy

Surveyed June 17 1957, by Tm. Bish