


**T16S, R16E
SECTION 14 WM**

CROOK COUNTY, OREGON

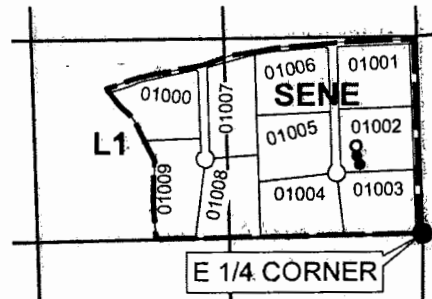

RECEIVED BY OWRD

OCT 24 2013

SALEM, OR


WELL LOCATED 610' N; 400' W OF E 1/4 CORNER

• METER

◦ WELL

 TAX LOTS

 SERVICE AREA BOUNDARY

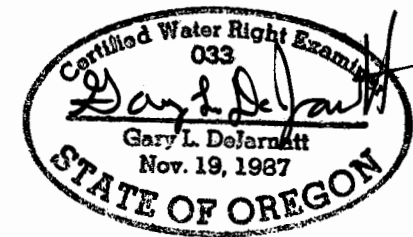

RENEWAL DATE 12-31-2013

**CLAIM of BENEFICIAL USE MAP
for BILL AVANTS**

TRANSFER T-8831

NOTE: THIS MAP IS NOT INTENDED TO
PROVIDE LEGAL DIMENSIONS OR LOCATIONS
OF PROPERTY OWNERSHIP LINES.

PROJECT # 13075

SEPT 19, 2013

WATER RIGHT SERVICES, LLC
PO BOX 1830, BEND, OR 97709
WWW.OREGONWATER.US

541-389-2837

JOHNSHORT@USA.COM